

Project: Spectrum Finishing - Remedial Action
 Contractor: EnviroTrac Environmental Services
 CDM Job No: D-006956 Site No. 1-52-029
 CDM Project Manager: John Blaum

CDM
 100 Crossways Park West
 Woodbury, NY 11797
 Telephone: 516.496.8400
 Fax: 516.496.8864

DAILY REPORT

Day:

S	M	T	W	TH	F	S
---	---	---	---	----	---	---

 Date: 28-May-09
 REPORT No. 152
 PAGE No. 1

WEATHER	Clear	Partly Cloudy	Overcast	Light Rain	Snow
TEMP L/H		58/61			
HUMIDITY	Dry	Moderate	High		
WIND	Calm	Light	Moderate	High	
WIND DIR	N	E	S	W	
	NE	SE	SW	NW	

PREPARED BY: F.Robinson TITLE: Inspector

AVERAGE FIELD FORCE

Name of Contractor	Title	Hours Worked	Remarks
EnviroTrac	Construction Manager	1x8 hrs	M.Rose
EnviroTrac	Operator	2x8 hrs	B.Gimbel, J.Byrnes
EnviroTrac	Technician	2x8 hrs	K.Davies, R.Maletta
Cork and Sons	Operator	1x8 hrs	G.Cork
Cork and Sons	Technician	2x8 hrs	E.O'Connor, J.Moreno

EQUIPMENT AT THE SITE I = Idle W = Working

20" Storage Container - W	Cork and Sons: Mack Dump Truck - W
Daewoo 450 skidder - W	Cork and Sons Case 580 Backhoe - W
CAT 430E Backhoe -W	Cork and Sons Case CX225SR Excavator - W
Case 621C Front End Loader - I	

HEALTH AND SAFETY

Name	Time (From - To)	Task/Level of PPE
		All workers onsite were in level D-PPE

CONSTRUCTION ACTIVITIES

Site Representative: Frank Robinson - CDM
Health and Safety Site Officer: N/A
DESCRIPTION OF WORK PERFORMED AND OBSERVED
1-Tailgate H&S meeting performed before the start of the work day. No air monitoring today due to light rain/drizzle all day.
2-Cork and Sons performed the following work at 61 Cabot St.: CP-11 was removed and PDS-3 was installed at its location. The structure was wrapped in filter fabric and backfilled with clean material. CP-11 was in a contaminated soil area and the soil was removed and stockpiled at the hazardous soil stockpile. No visibly contaminated material was observed inside or outside CP-11. The excavator bucket and dump truck was decontaminated after work was finished. The eastern most roof drain that ran to DS-4 was redirected to run to PDS-3.
3-EnviroTrac installed forms for the replacement sidewalk in front of 51 Cabot St.
4-EnviroTrac sampled CP-10 (60 Dale St.) for TPH and metals to determine where the liquid can be disposed of due a sheen on the surface of the water.

x - Designates report is continued on additional pages

CDM Site Representative: F. Robinson Project Manager: John Blaum

PHOTOGRAPHIC LOG
28-May-09
CDM Job No. D-006956
Spectrum Finishing Remedial Action
SITE No. 1-52-029

PHOTO	DATE	TIME	DESCRIPTION
100_0721.jpg	5/28/2009	AM	Replacement sidewalk in front of 51 Cabot St. prepped for concrete
100_0712.jpg	5/28/2009	AM	CP-11, 61 Cabot St., partially excavated out
100_0717.jpg	5/28/2009	AM	PDS-3, 61 Cabot St, both rings installed
100_0722.jpg	5/28/2009	PM	Eastern most roof drain, 61 Cabot St., redirected from DS-4 to PDS-3
100_0723.jpg	5/28/2009	PM	Eastern most roof drain, 61 Cabot St., redirected from DS-4 to PDS-3
100_0724.jpg	5/28/2009	PM	PDS-3 and redirected roof drain backfilled

PHOTOS 5/28/09



100_0721.jpg - Replacement sidewalk in front of 51 Cabot St. prepped for concrete



100_0712.jpg - CP-11, 61 Cabot St., partially excavated out



100_0717pg - PDS-3, 61 Cabot St., both rings installed




100_0722.jpg - Eastern most roof drain, 61 Cabot St., redirected from DS-4 to PDS-3



100_0723.jpg - Eastern most roof drain, 61 Cabot St., redirected from DS-4 to PDS-3



100_0724.jpg - PDS-3 and redirected roof drain backfilled

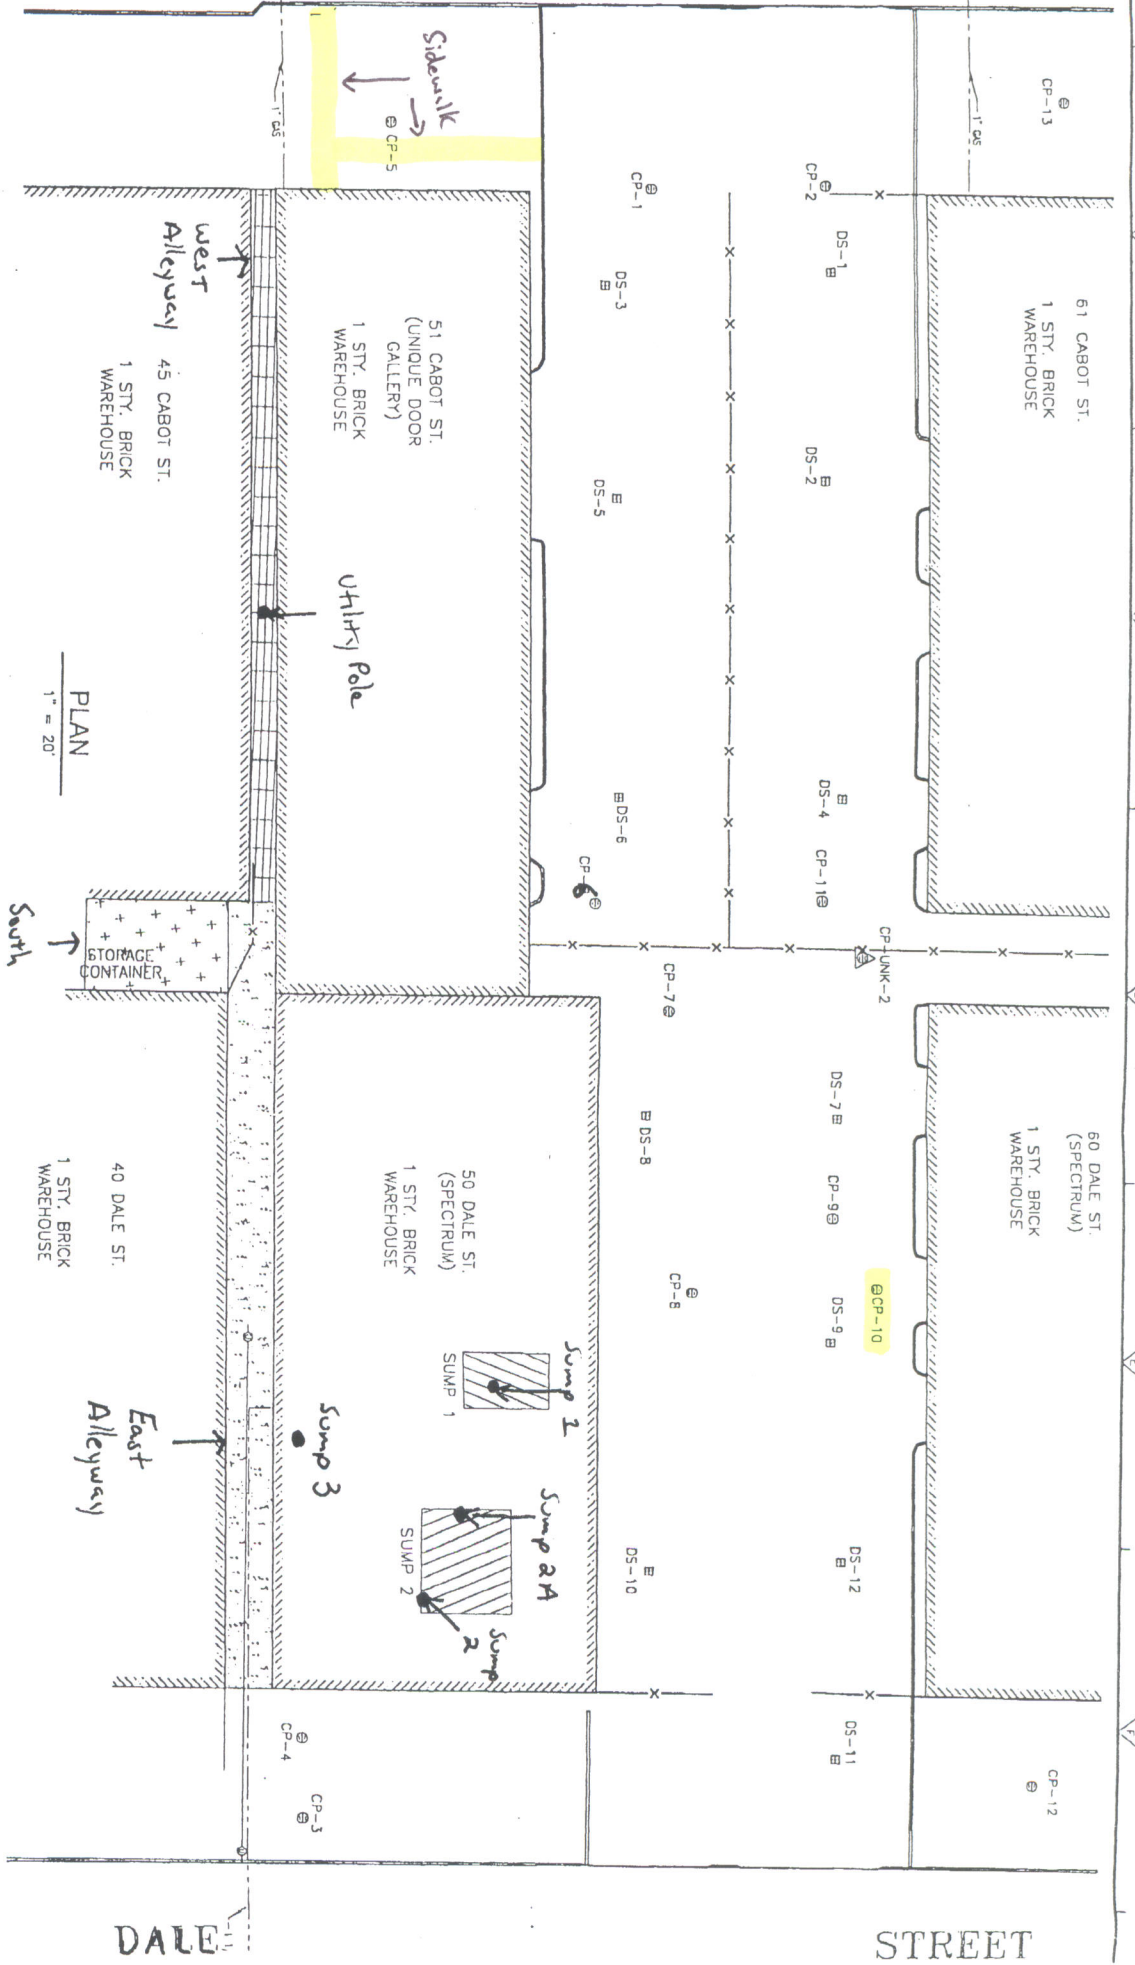


PLAN
1" = 20'

5/28/09
Work Areas

DALE

STREET

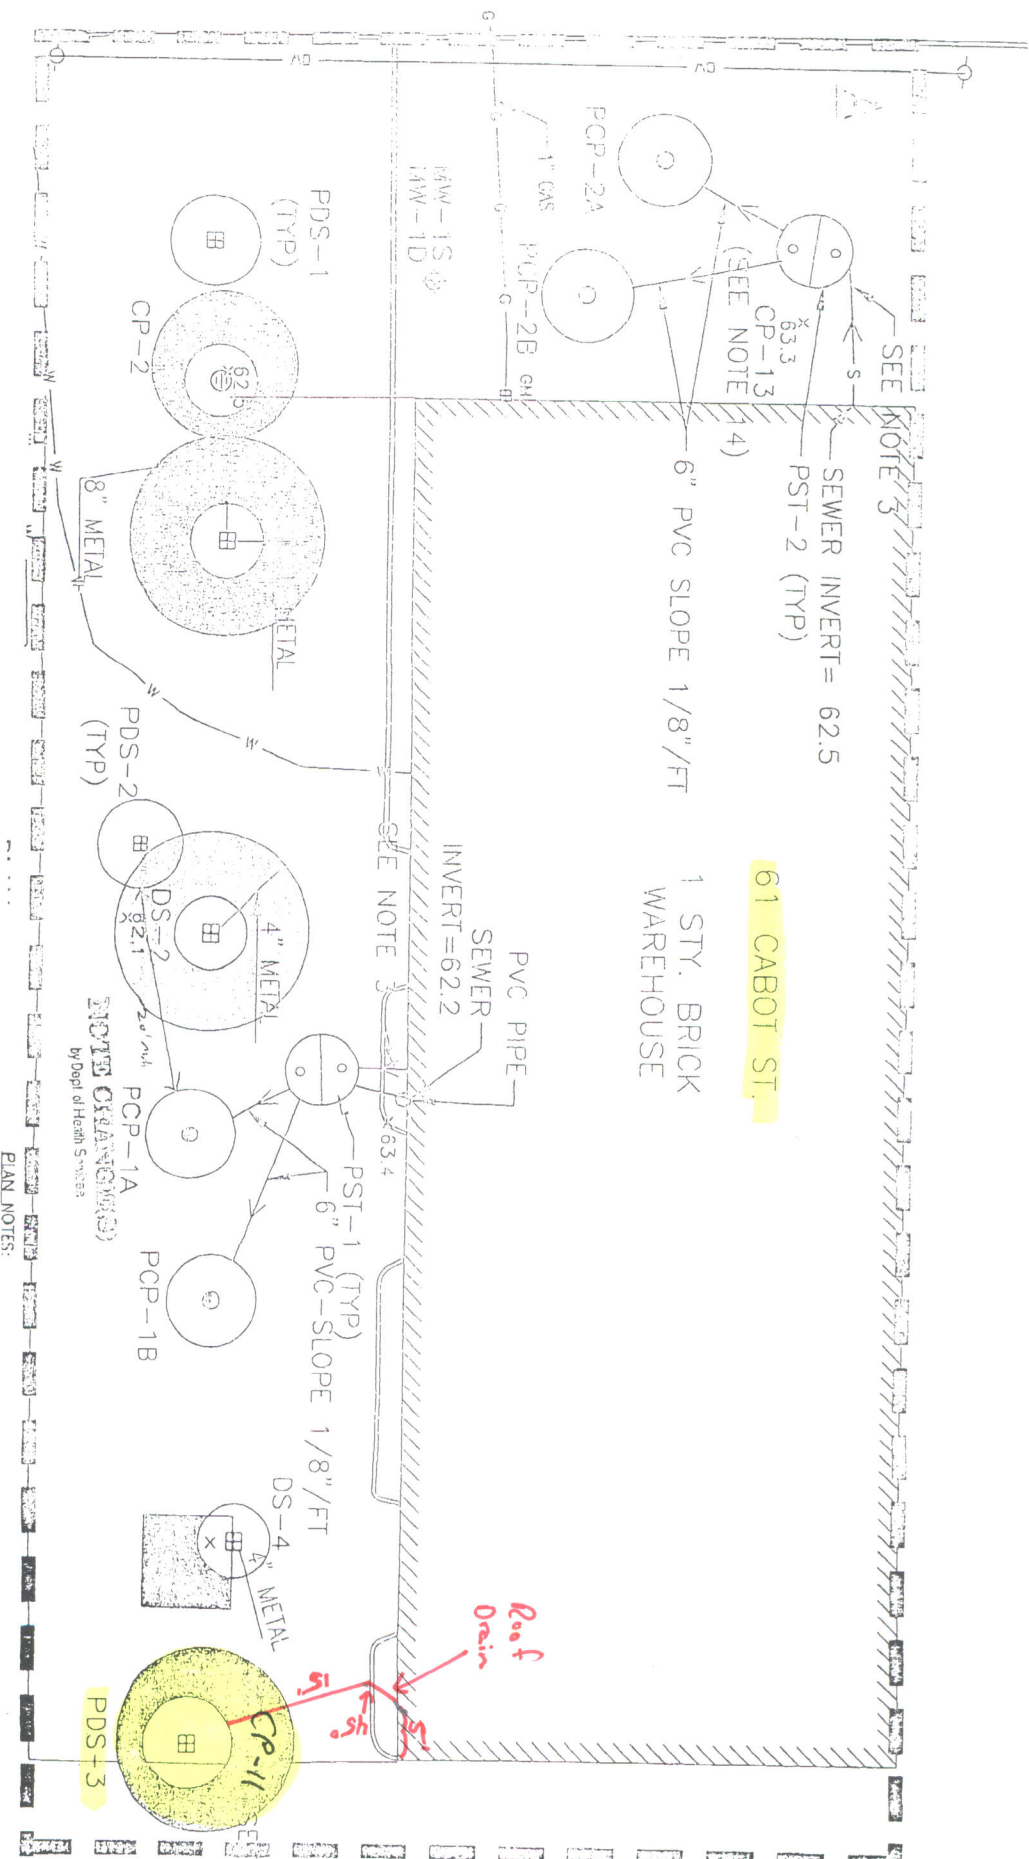

61 CABOT ST.


1 STY. BRICK WAREHOUSE

5/28/09

PLAN NOTES:

NOT TO SCALE
by Dept. of Health Services

Roof Drain
15'
45'

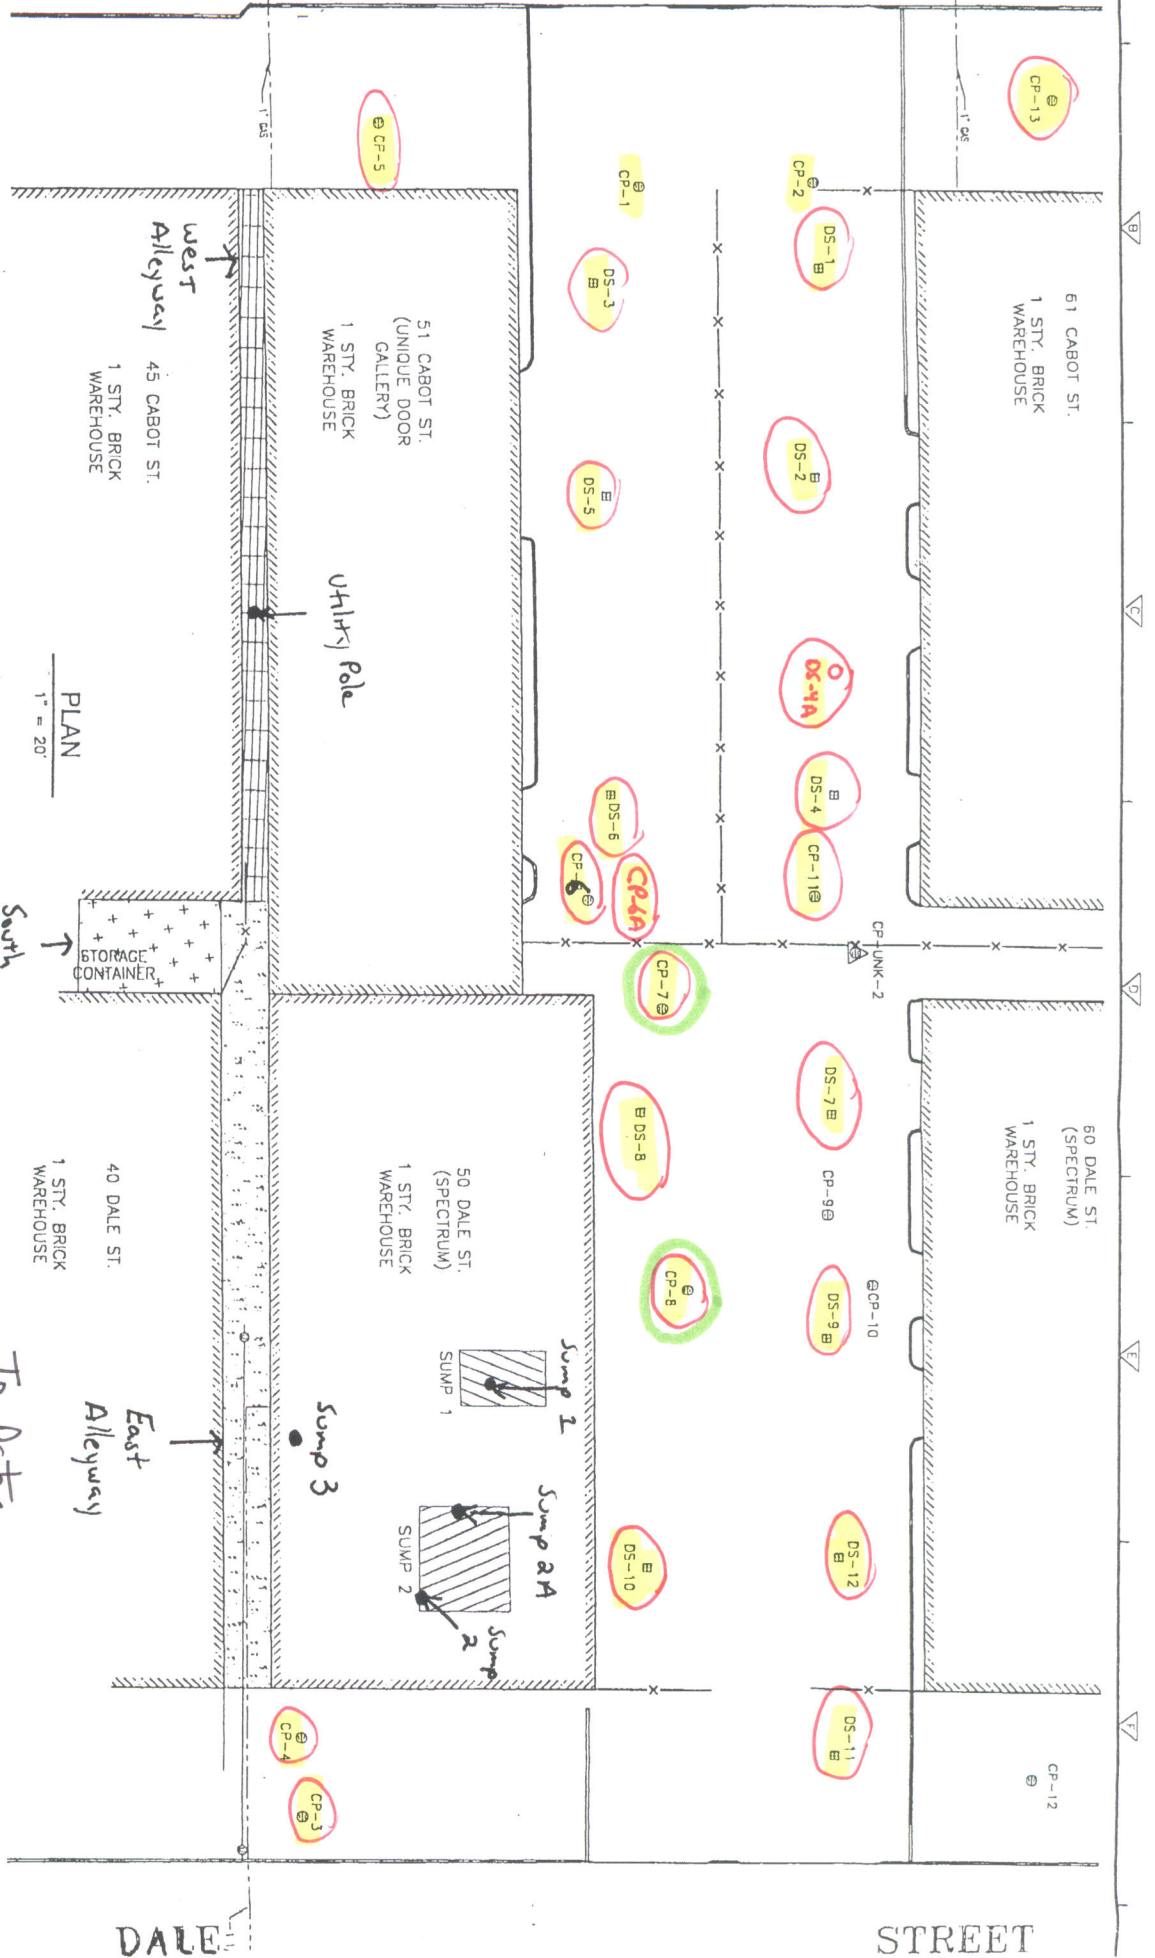

PLAN
1" = 20'

- To Date:**
- Structures cleared out
 - end point sampled
 - Abandoned

DALE

STREET