

APPENDIX H

TDCS PERMANENT PUMP SYSTEM INSTALLATION

Contents of Appendix H

Permanent Pump System Installation

Text	Summary of Permanent Pump System Installation
Figure 3-1	TDCS Site Plan May 2009
Figure 3-2	Utility Tunnel Piping May and November 2009
Figure 3-3	TDCS Site Plan Pretreatment System Removal
Figure 3-4	TDCS Site Plan November 2009

Design Drawings

C-3	Underground Utility Plan
S-9	Sump Framing Plan and Detail
PID	Piping and Instrumentation Diagram
M-11	Piping Layout Plan and Elevation
E-9	Electrical Plans and Diagrams

SUMMARY OF PERMANENT PUMP SYSTEM INSTALLATION

The original TDCS Phase 4 Construction drawings includes the Final Build Out of the TDCS and was expected to begin after the six month performance-monitoring and evaluation period following the completion of the piezometers and drain wells installation. However, with the failure of the temporary pump only three weeks after the demobilization of the TDCS construction contractor, the temporary pumping system was deemed unreliable and it was therefore decided that the permanent pumps and some other key components that were originally included in Phase 4 would need to be installed before the end of Phase 3 performance monitoring. In addition, other items related to improvements to the TDCS were implemented.

The Phase 4 items and activities included: two vertical turbine pumps; variable frequency drive controllers; sump level transmitters; Ethernet (fiber optic) communication link from the TDCS to the Hudson Falls WTP; pump base frame; sump cover support frame and deck; access ladder; pump discharge hoses and pipe header support bracket; HF-303 piping to TDCS tunnel gutter; TDCS piping from shaft to utility tunnel; electrical shed and; reconfiguration of drain piping from spoils structure. The installation of new piping required the coordinated removal of the temporary pre-treatment system weir (frac) tanks and a new connection to the TDCS discharge (process water) pipe in the utility tunnel beneath John Street.

RE-DESIGN AND PROCUREMENT

The re-design of the permanent pump system and support deck and framing as well as plans for permanent piping and removal of the temporary piping and pre-treatment system began in early June 2009. The TDCS average weekly flow was about 70 gallons per minute one week after opening the drain wells and this value was used for determining the discharge capacity of the permanent pumps for the TDCS Lift Station. The pump support structure design was changed from cast-in-place concrete to all steel construction and included a steel frame and deck to cover the open top of the elevator sump, for safety reasons. The pumps were selected and ordered on July 16, 2009 with a 12 week delivery (October 8, 2009). The long lead time was attributed to the special motor required for the corrosive environment in the TDCS bell-out and sump. The control cabinet was ordered on August 26, 2009 with a delivery date of September 15, 2009. The structural steel for the sump deck was ordered on September 8, 2009. A safety improvement to the TDCS shaft cover was made, including adding a galvanized steel hand rail

with toe plate around the hatch opening (9 ft x12 ft). The hand rail was ordered on September 18, 2009 and installed on October 13, 2009. Additionally, a weather-protected structure (electrical shed) was required for the electrical panel and control cabinet for the new pumps. The electrical shed was located immediately adjacent to the TDCS shaft collar and housed the new pump control equipment, as well as the existing electrical, instrumentation and control equipment including electrical power feeds, transformer, panels, shunt trip switch, emergency backup pump controller, auto-dialer and TDCS piezometer data acquisition system data logger.

VERTICAL TURBINE PUMPS RE-DESIGN

The permanent pumps in the original design of the TDCS lift station included a duplex pump system consisting of two vertical turbine pumps each designed for a discharge of 250 gallons per minute and total dynamic head of 300 feet. These pumps were selected prior to construction based on the estimated TDCS flow rate of 110 gpm with a large safety factor. This is over-designed for the actual TDCS total flow of 70 gallons per minute that existed at the end of Phase 3 Construction and therefore, a re-design and re-sizing of the pumps was required. The selected pump capacity was 125 gallons per minute with a total dynamic head of 300 feet. Other changes in the pump design included a motor for corrosive duty with a chemical resistant coating due to the constant groundwater seepage through the shotcrete lining in the TDCS shaft. The pump was required to have a stainless steel shaft, impeller, bowl coupling and mechanical seal. The power feed from the electrical panel at the top of the shaft was included as a more reliable configuration than the temporary electrical panel at the bottom of the shaft which has proven to be problematic due to the constant presence of water and high humidity.

PUMP SUPPORT AND SUMP DECK

The cover over the sump at the bottom of the shaft was left by the general contractor and included a temporary arrangement of steel plates, crane mat timbers, and plywood decking. In order to install the new vertical turbine pumps, the sump deck and pump support frame needed to be installed. The original design for the pump support was a composite galvanized steel and concrete deck slab supported by steel beams. The placing of concrete in the bell-out for the pump support slab would be time consuming and difficult to complete and still achieve a high degree of quality control. Therefore, the pump support was re-designed to consist of all steel instead of a composite deck. For safety, reasons the entire top opening of the sump needed to be

covered. The original design of the sump deck was steel beams supporting steel grating with checker (diamond) plate welded to the top. The original design included no provision for a deck over the Elevator Sump. The design concept for the sump deck was also used for the top of the Elevator Sump. Additionally, an access door with handrail and ladder to the bottom of the sump was included in the re-design of the sump deck. The final pump support and sump deck were all-steel construction and hot dipped galvanized after shop welding.

VERTICAL TURBINE PUMPS INSTALLATION

The new vertical turbine pumps were delivered on October 12, 2009, and the pump control cabinet was delivered on October 27, 2009. The installation of the vertical turbine pumps included the control cabinet, power cables and control signal wiring from the controller to the pumps, the pump base frame, the pump, and the drive motor. The installation process began on October 29, 2009, and was interrupted on November 3, 2009, when the final assembly of the pumps could not be completed due to improper mechanical seal components. The proper components were delivered and the final assembly completed on November 18, 2009. The permanent vertical turbine pumps were commissioned and placed in service on November 19, 2009.

PUMP DISCHARGE LINES

The temporary pump discharge lines from the temporary pumps (left by the general contractor) consisted of two 4-inch diameter hoses from the pumps in the sump to a separate 4-inch check valve connected to a 4-inch steel pipe welded to a 6-inch steel pipe header. The backup pump on the bell-out invert had a 6-inch diameter discharge hose connected to a 6-inch check valve and 90 degree elbow into the bottom of the 6-inch steel pipe header. The header pipe is connected to the 6-inch steel Victaulic pipe that is fastened to the wall of the bell-out and shaft and continues through a 90 degree elbow and through the shaft collar concrete and underground to the pre-treatment system weir tanks. During the installation of the vertical turbine pumps, new chemical resistant hoses consisting of polyethylene tubes inside Ethylene Propylene Dimonomer [EPDM] covers were installed from the vertical turbine pumps to the header. The hose from the ABS pump is 6-inch diameter EPDM hose. The EPDM hose is inspected during each entry to the TDCS.

DECOMMISSIONING OF TEMPORARY PRE-TREATMENT SYSTEM

A temporary pre-treatment system was installed prior to the start of the TDCS construction. The system was in place during the construction and was needed to remove sediment from the construction water before final processing in the on-Site WTP. The temporary pre-treatment system included the piping from the TDCS Shaft and the Spoils Structure to the two 18,000 gallon weir (frac) tanks, piping from the tanks to the TDCS process water piping, two booster pumps in the utility tunnel beneath Allen Street, and an overflow pipe from the North Tank to the South Basin. After construction, the TDCS discharge water was mostly free of sediment and the pre-treatment system was no longer needed. Refer to Figures 3-1 and 3-2 for TDCS Site Plan features as of May 2009 following the demobilization of the TDCS Contractor. The pre-treatment system removal work was sequenced to facilitate both the removal of the temporary pre-treatment system and the installation of the permanent piping so as to minimize the downtime of the TDCS pump outage required to make the final connections. The pre-treatment system was taken out of service on October 19, 2009 when the permanent piping system was connected to the TDCS discharge pipe at the top of the TDCS shaft. Refer to Figure 3-3, TDCS Site Plan for the pre-treatment system removal information.

WEIR TANK REMOVAL

The South Tank was located over the alignment of the permanent TDCS process water piping and therefore was removed first on July 17, 2009, to allow for the permanent pipe installation. The North Tank remained in operation until permanent piping was completed and in service on October 19, 2009. The following procedure was used to decommission both tanks before the tanks were demobilized from the Site. Prior to removal, all piping connections to the tank were removed and piping was either placed in contaminated storage area on site or properly disposed off site. The tank was emptied using a vacuum truck, to remove water and sediment. The water was decanted into the North Basin and the sediment was dumped into a roll-off and stabilized with cement prior to proper disposal off site. Once the tank was empty, it was moved to the North Basin decontamination pad where it was decontaminated and wipe samples collected. The Tanks were cleaned until acceptable wipe tests were achieved (i.e. a total PCB concentration of less than 10 micro grams per wipe). When acceptable wipe test results were achieved the tank was removed by the tank rental company. The South Tank was removed from

the Site on August 31, 2009, and the North Tank on December 15, 2009. The results of the tank wipe samples are summarized in the following Table.

TABLE: FRAC TANK CLEANING WIPE TESTS

Date Sampled/Wipe	PCB 1016	PCB 1221	PCB 1232	PCB 1242	PCB 1248	PCB 1254	PCB 1260
8/18/2009							
Wipe 1	ND	ND	ND	1.95	ND	ND	ND
Wipe 2	ND						
Wipe 3	ND	ND	ND	1.17	ND	ND	ND
Wipe 4	ND	ND	ND	0.783	ND	ND	ND
Wipe 5	ND	ND	ND	4.06	ND	ND	ND
12/5/2009							
Wipe 008F	ND	ND	ND	3.02	ND	ND	ND
Wipe 009F	ND						
Wipe 010F	ND	ND	ND	0.791	ND	ND	ND
Wipe 011F	ND						
Wipe 012F	ND						
Wipe 013F	ND						
LIMITS	0.500 µg/Wipe						

Notes: ND = Non-Detect

PERMANENT UNDERGROUND PIPING

The permanent piping replaced the temporary piping and made a direct connection from the TDCS and from the spoils structure drain sump pump to the existing piping in the utility tunnel. The permanent TDCS process piping (double containment pipe with 4-inch Schedule 80 PVC inside 8-inch Schedule 80 PVC pipe with centralizers) was installed from the utility tunnel through the existing concrete bulkhead beneath Allen St. to the utility pipe sleeves on the east side of the TDCS shaft. The spoils drain line was cut and connected to new piping where it crossed the new alignment of the permanent TDCS discharge pipe. Installation of the permanent piping began on July 27, 2009. The piping installation included coring holes through the concrete bulkhead for permanent piping, conduits for signal circuits and fiber optic cables. The TDCS process water piping was connected to the existing 6 in PVC Schedule 80 process water pipe that runs to the WTP. A 6 in diameter check valve was installed in the 6 in process line to

the WTP. The Spoils Structure drain (4 in PVC Schedule 80) was mounted to the wall of the utility tunnel with outlet directly into the existing John Street Sump. Refer to Figure 3-4 for the TDCS site layout and Figure 3-2 for the piping layout in the Utility Tunnel as of November 2009, after completion of the permanent pump system installation.

SAFETY IMPROVEMENTS TO TDCS SHAFT COVER

The shaft cover has a 9 ft x12 ft hatch in the center to facilitate entry into the shaft without having to remove the entire shaft cover. In order to improve the safety of personnel working near the hatch opening during crane operations, a handrail was added around the hatch opening. The railing includes a toe or kick plate to prevent small items from going over the edge of the hatch opening. The safety of personnel on the shaft collar when the entire shaft cover is removed is dependent on adequate fall protection features around the collar.

ELECTRICAL SHED IMPROVEMENTS

A new electrical shed was constructed to accommodate the existing electrical equipment and the items required for the permanent pump system. At the completion of the drain wells, the existing TDCS electrical equipment including electrical transformer; shunt trip switch; load panels and; ABS pump controller, were housed immediately adjacent to the shaft collar in a small open structure with three sides and a roof. In June 2009 an auto-dialer for alarm conditions in the TDCS was added. The new electrical equipment required for the permanent pump system included a large control panel, Ethernet panel, and room for a power conditioning transformer if it is found to be necessary. A new structure was required to protect the electrical equipment from the weather. The electrical shed (interior height 8 ft x 14 ft x 8 ft) on a concrete slab with 2 x 6 walls and roof and is sided with T-111 plywood. There is one man-door and no windows and it is not insulated. The existing electrical structure walls and roof were removed and the new shed was constructed over the existing electrical equipment. The piezometer data logger is also located in the electrical shed.

ETHERNET COMMUNICATION LINK TO WTP

The WTP control room is located about ¼ mile away from the TDCS shaft lift station. Information on the real-time status of the TDCS pump system is important for managing water and the WTP. Prior to the TDCS, an existing fiber optic cable link connected computers in Building 12 to the WTP control room. A new fiber optic cable with ethernet hardware was

installed to make a complete data communication circuit between the TDCS electrical shed and the water treatment plant control system. Data are sent to the WTP control system from the two vertical turbine pump controllers (sump water level, motor current and rpm), the emergency backup pump controller (on-off data) and, the TDCS flow meter (located in the utility tunnel beneath John Street). The programming for the WTP control system was revised to use, record and display the new data available from the TDCS.

SUMP LEVELS AND AUTO-DIALER ALARMS

The following are the sump water levels and associated attributes (sump levels measured from the bottom of TDCS Sump):

Backup Pump, P3 (ABS), OFF: 3 feet;

Vertical Turbine Pumps, P1 & P2, Set Point: 4.33 feet (52 inches);

Backup Pump, P3 (ABS), ON – ALARM – Autodialer callout: 7 feet;

High Water (per LVT Programmed) – Autodialer callout: 8 feet;


High Water Float – ALARM Autodialer callout: 9 feet and;

Shunt Trip Float – ALARM Autodialer callout: 11 feet (1 feet above top of sump wall).

Other Autodialer ALARM callouts include:

Loss of power to Autodialer, i.e. NO Power Need Generator and;


Low Battery on Autodialer.

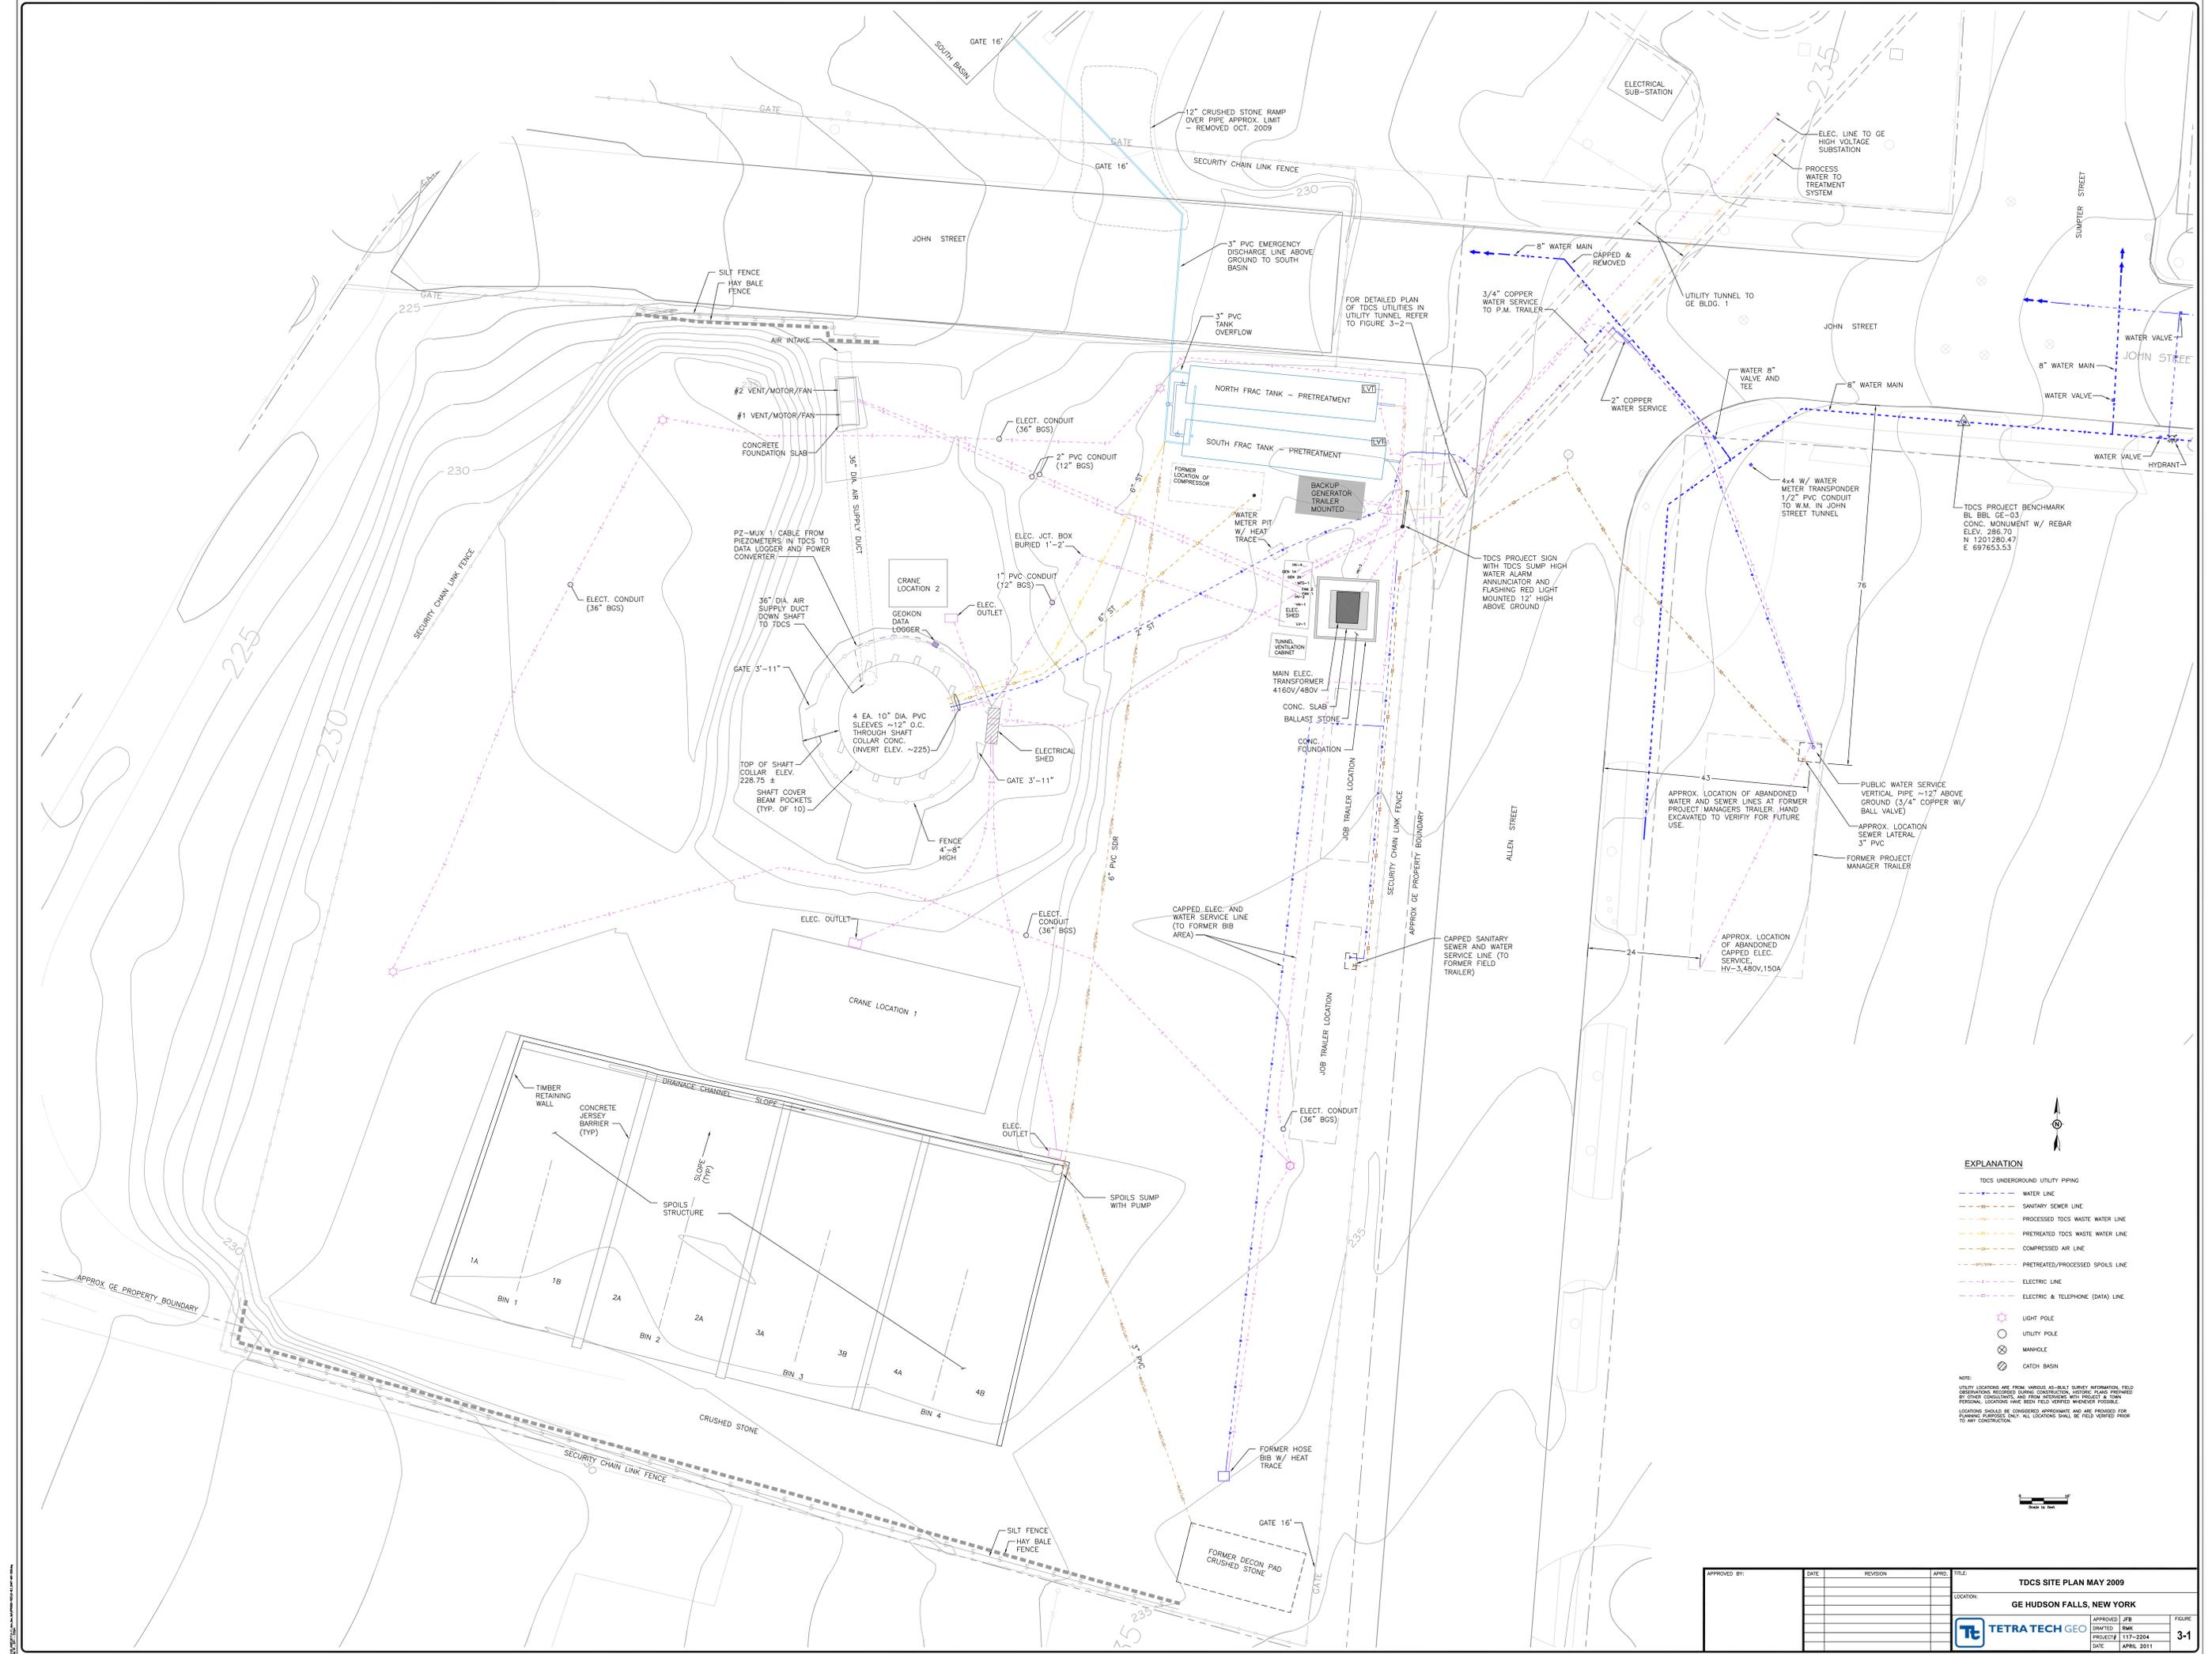


- EXPLANATION**
- TDCS UNDERGROUND UTILITY PIPING
 - WATER LINE
 - SANITARY SEWER LINE
 - PROCESSED TDCS WASTE WATER LINE
 - PRETREATED TDCS WASTE WATER LINE
 - COMPRESSED AIR LINE
 - PRETREATED/PROCESSED SPOILS LINE
 - ELECTRIC LINE
 - ELECTRIC & TELEPHONE (DATA) LINE
 - LIGHT POLE
 - UTILITY POLE
 - MANHOLE
 - CATCH BASIN

NOTE:
 UTILITY LOCATIONS ARE FROM VARIOUS AS-BUILT SURVEY INFORMATION, FIELD OBSERVATIONS RECORDED DURING CONSTRUCTION, HISTORIC PLANS PREPARED BY OTHER CONSULTANTS, AND FROM INTERVIEWS WITH PROJECT & TOWN PERSONNEL. LOCATIONS HAVE BEEN FIELD VERIFIED WHEREVER POSSIBLE.
 LOCATIONS SHOULD BE CONSIDERED APPROXIMATE AND ARE PROVIDED FOR PLANNING PURPOSES ONLY. ALL LOCATIONS SHALL BE FIELD VERIFIED PRIOR TO ANY CONSTRUCTION.

APPROVED BY:	DATE:	REVISION:	APPRO:	TITLE:
				TDCS SITE PLAN MAY 2009
LOCATION: GE HUDSON FALLS, NEW YORK				
		APPROVED: JFB DESIGNED: BJK PROJECT#: 117-2204 DATE: APRIL 2011	FIGURE: 3-1	

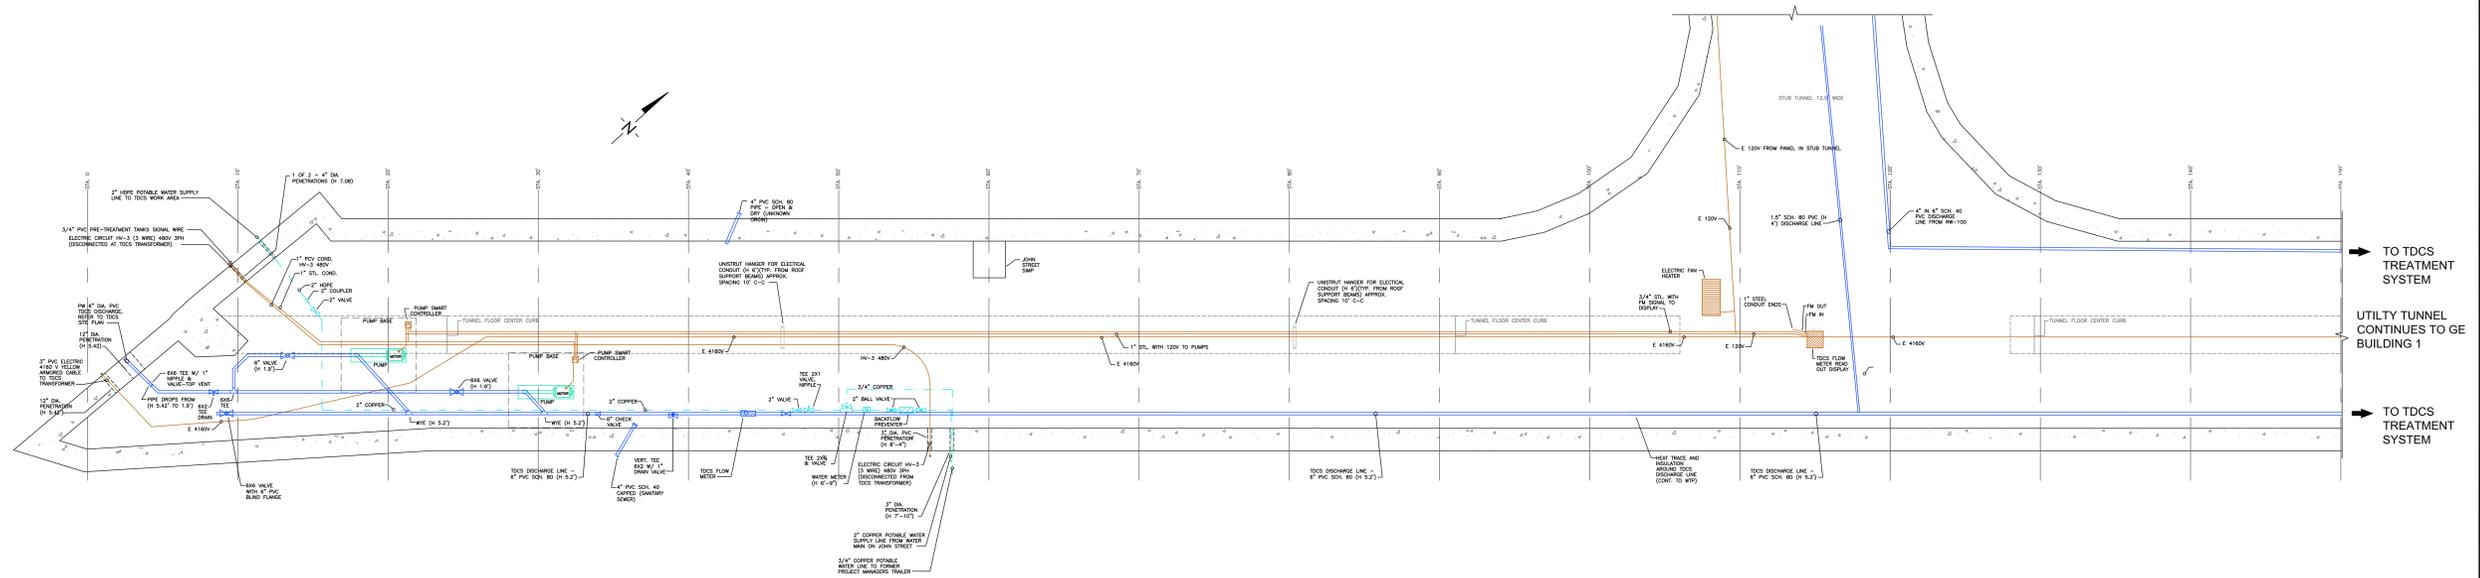

TDCS UTILITY PIPING MAY 2009 - UTILITY TUNNEL PLAN


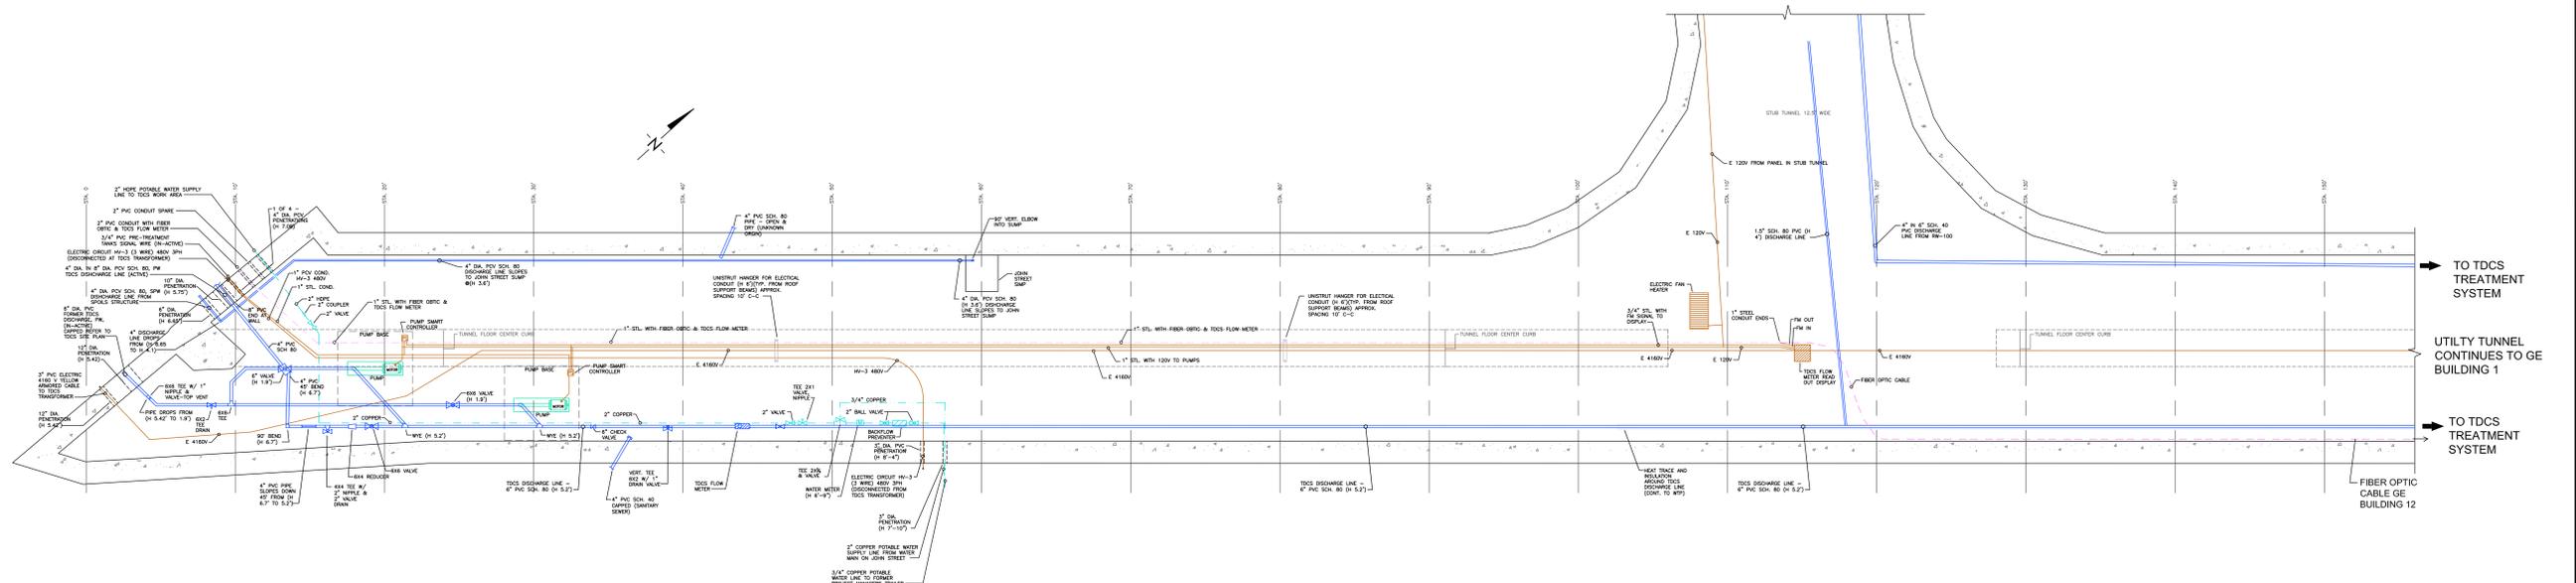


TDCS UTILITY PIPING NOVEMBER 2009 - UTILITY TUNNEL PLAN



NOTE: INFORMATION SHOWN IS THE RESULT OF A TAPE SURVEY. LOCATIONS ARE APPROXIMATE AND MAY HAVE CHANGED DUE TO ON GOING SITE ACTIVITIES.


APPROVED BY:	DATE:	REVISION:	APRD:	TITLE:
				TDCS UTILITY TUNNEL PIPING MAY & NOVEMBER 2009
LOCATION: GE HUDSON FALLS, NEW YORK				
APPROVED: JFB	DATE: APRIL 2011	PROJECT#: 117-2204	FIGURE: 3-2	
DRAWN: RMC				

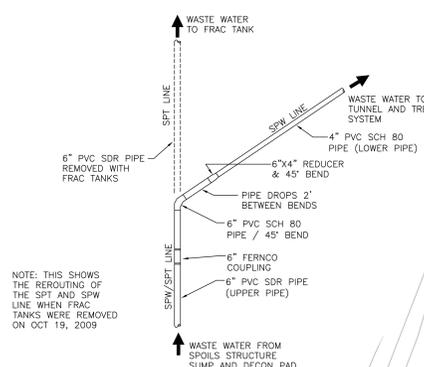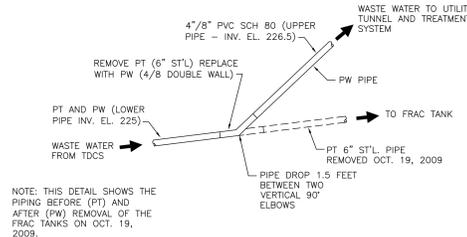


- EXPLANATION**
- TDCS UNDERGROUND UTILITY PIPING
 - WATER LINE
 - SANITARY SEWER LINE
 - PROCESSED TDCS WASTE WATER LINE
 - COMPRESSED AIR LINE
 - PRETREATED/PROCESSED SPOILS LINE
 - FIBER OPTIC LINE
 - ELECTRIC LINE
 - ELECTRIC & TELEPHONE (DATA) LINE
- HUDSON FALLS UTILITY LINES AS SHOWN IN DAMES & MOORE MAPPING FROM 1990'S (FOR REF. ONLY)
- ☆ LIGHT POLE
 - UTILITY POLE
 - ⊗ MANHOLE
 - ⊙ CATCH BASIN

NOTE: UTILITY LOCATIONS ARE FROM VARIOUS AS-BUILT SURVEY INFORMATION, FIELD OBSERVATIONS RECORDED DURING CONSTRUCTION, HISTORIC PLANS PREPARED BY OTHER CONSULTING ENGINEERS, AND DAMES & MOORE MAPPING. LOCATIONS SHOULD BE CONSIDERED APPROXIMATE AND ARE PROVIDED FOR INFORMATION PURPOSES ONLY. ALL LOCATIONS SHALL BE FIELD VERIFIED PRIOR TO ANY CONSTRUCTION.

APPROVED BY:	DATE:	REVISION:	APPRO:	TITLE:
				TDCS SITE PLAN PRETREATMENT REMOVAL
LOCATION: GE HUDSON FALLS, NEW YORK				
APPROVED: JFB	DATE: 11/7-2004	FIGURE:	3-3	
PROJECT: 117-2204	DATE: APRIL 2011			

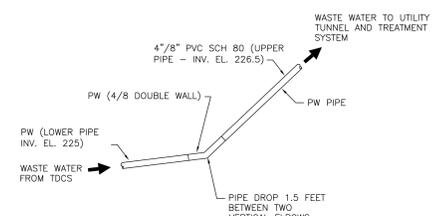

DETAIL 2
NOT TO SCALE

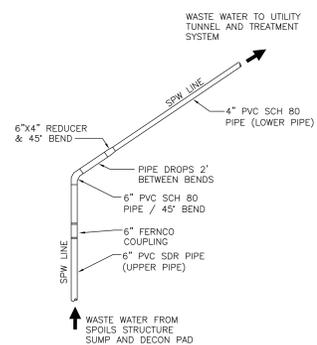


DETAIL 1
NOT TO SCALE



- EXPLANATION**
- TDCS UNDERGROUND UTILITY PIPING
 - WATER LINE
 - SANITARY SEWER LINE
 - PROCESSED TDCS WASTE WATER LINE
 - COMPRESSED AIR LINE
 - PROCESSED SPOILS LINE
 - FIBER OPTIC LINE
 - ELECTRIC LINE
 - ELECTRIC & TELEPHONE (DATA) LINE
- HUDSON FALLS UTILITY LINES AS SHOWN IN DAMS & MOORE MAPPING FROM 1990'S (FOR REF. ONLY)
- LIGHT POLE
 - UTILITY POLE
 - MANHOLE
 - CATCH BASIN

NOTE:
UTILITY LOCATIONS ARE FROM VARIOUS AS-BUILT SURVEY INFORMATION, FIELD OBSERVATIONS, RECORDS DURING CONSTRUCTION, HISTORIC PLANS PREPARED BY OTHER CONSULTING ENGINEERS, AND OTHER SOURCES. LOCATIONS SHOULD BE VERIFIED PRIOR TO ANY CONSTRUCTION.


APPROVED BY:	DATE:	REVISION:	APPRO:	TITLE:
				TDCS SITE PLAN NOVEMBER 2009
LOCATION: GE HUDSON FALLS, NEW YORK				
		APPROVED: JFB DRAWN: RMC PROJECT#: 117-2204 DATE: APRIL 2011	FIGURE: 3-4	

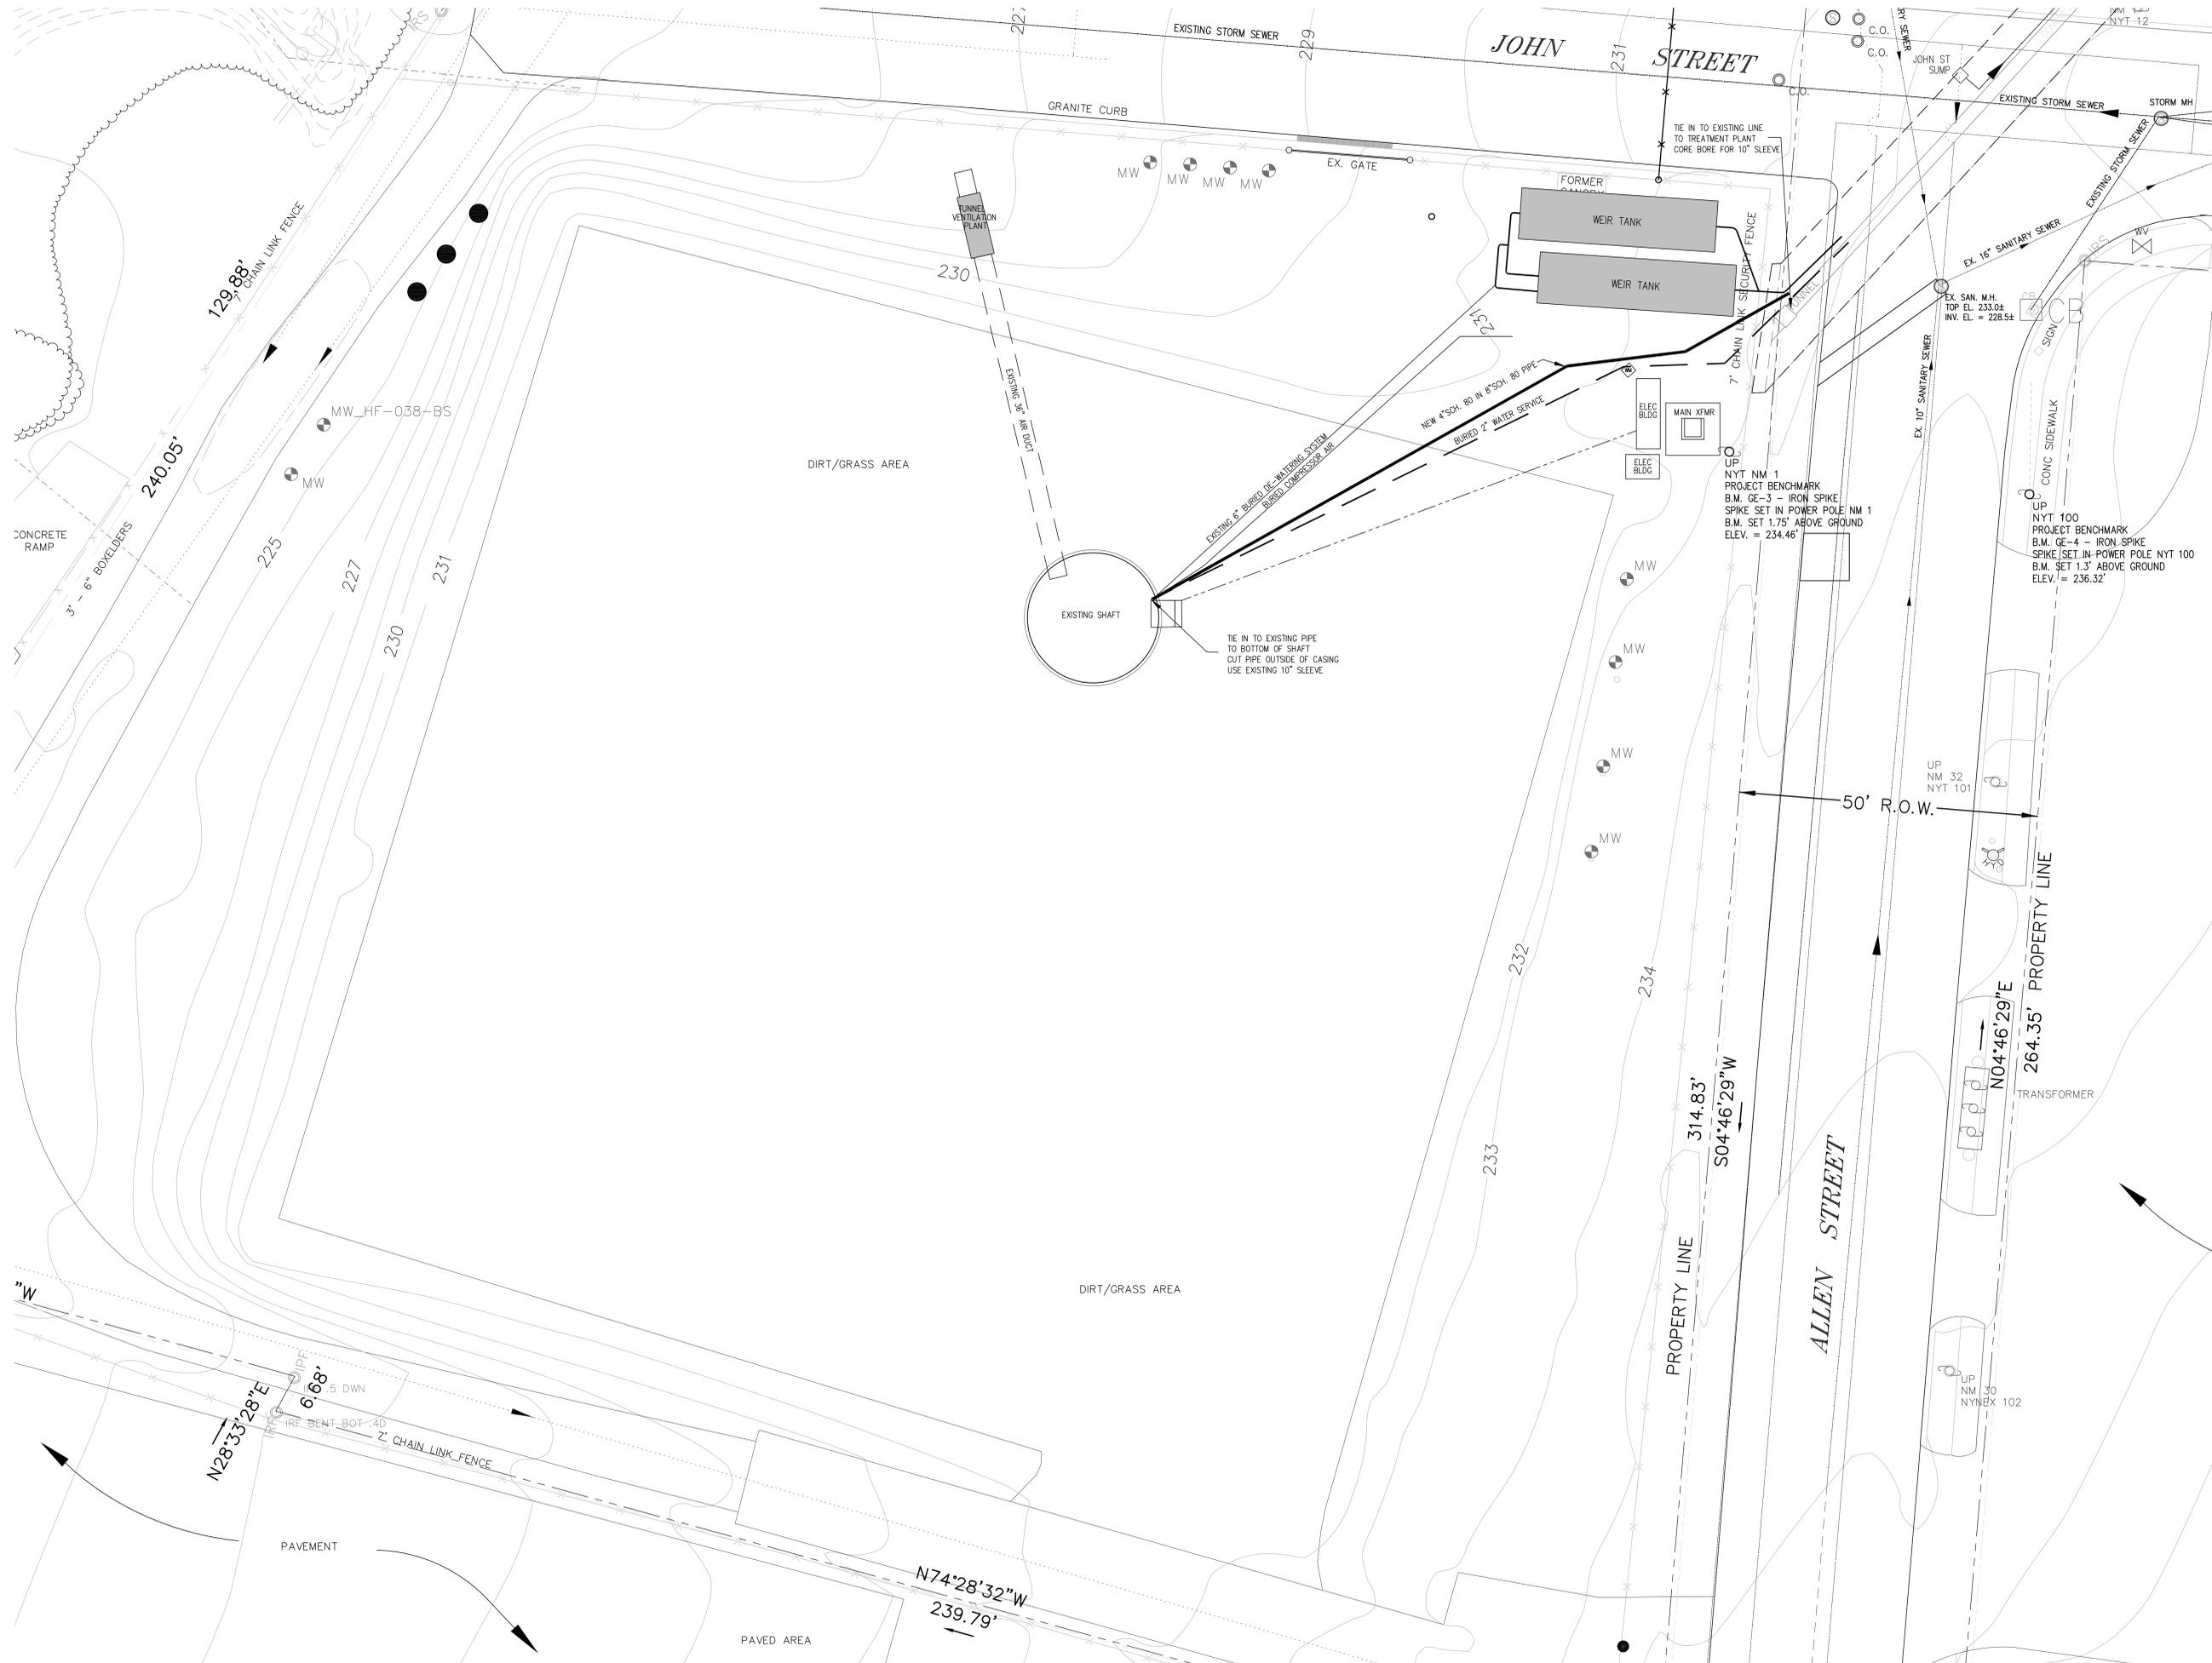

TETRA TECH ENGINEERS, ARCHITECTS & LANDSCAPE ARCHITECTS, P.C.
 56 West Main Street
 Christina, Delaware 19702-1501
 ph. 302 738-7551
 fax 302 454-5980
 www.tetrattech-de.com


RCN: 112IC02194
 DRAWN BY: SNL
 CHECKED BY: CD/HKM
 SCALE: 1"=10'-0"
 APPROVED BY: CKH
 DATE: 10 JULY 2009 10:10
 CAD FILE: C-3

General Electric Company
TUNNEL/ DRAIN COLLECTION SYSTEM
 Hudson Falls, New York
 CIVIL UNDERGROUND UTILITY PLAN
 DRAWING TITLE: C-3
 DRAWING NUMBER:

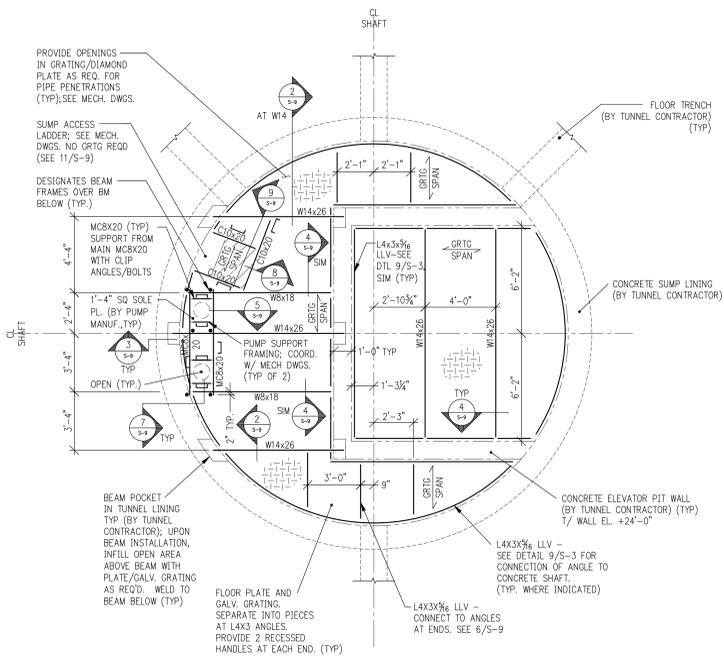


1 PLAN: FRAMING @ SUMP
 SCALE: 1/4" = 1'-0"
 NOTES:
 • T/W14x26 & T/W8x18 EL. +23'-10 1/2"
 • T/MC8x20 EL. +24'-6 1/2"
 • T/C10x20 EL. +23'-9 1/2"
 • ALL STEEL TO BE HOT-DIP GALVANIZED, G90 COATING, PER ASTM A123.
 • SIGNAGE TO INDICATE MAXIMUM ALLOWABLE PLATFORM LOADS AS FOLLOWS: DISTRIBUTED ≤ 250 PSF, POINT LOADS ≤ 750 LBS.
 • SEE 10/S-9 FOR DIMENSIONS TO PUMP SUPPORT/REMOVABLE GRATING SUPPORT FRAMING


2 SECTION: GRATING/BASE CONNECTION
 SCALE: 3/8" = 1'-0"
 NOTES:
 • SECURELY ATTACH FLOOR PLATE TO GRATING WITH HOLD DOWN CLIPS OR WELDS AS REQUIRED. IF HOLD DOWN CLIPS ARE USED, PROVIDE FLAT HEAD BOLTS AND COUNTERSINK FLUSH WITH PLATE.
 • INSTALL GRATING IN MAXIMUM 4'-0" x 6'-0" PANELS. PROVIDE MIN. OF 2 HANDLES PER PANEL. HANDLES SHOULD LAY FLUSH WITH TOP OF PLATE WHEN NOT IN USE.

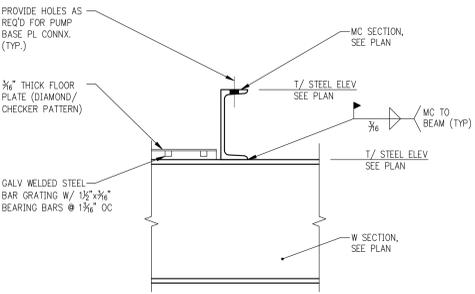


5 SECTION: CHANNEL BEARING ON BEAM
 SCALE: 1/2" = 1'-0"
 NOTES:
 • BREAK GRATING AT CHANNEL LOCATIONS AS REQUIRED PER PUMP INSTALLATION
 • AT CONTRACTOR'S OPTION, PROVIDE 2-3/4" DIA. BOLTS AT CHANNEL FLANGE TO BEAM FLANGE CONNECTION SHOWN (ONE BOLT EACH SIDE OF W SECTION BEAM WEB) IN LIEU OF WELDED CONNECTION

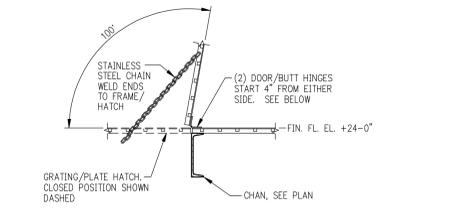


8 SECTION: GRATING HATCH AT OPNG
 SCALE: 3/8" = 1'-0"
 NOTES:
 • DOOR/BUTT HINGE TO BE 300 SERIES STAINLESS STEEL WITH 180 DEGREE RANGE OF MOTION, SIMILAR TO ITEM "1499414" AS MANUFACTURED BY McMASTER-CARR SUPPLY COMPANY, OR APPROVED EQUAL. ATTACH TO DIAMOND PLATE SURFACE WITH 4 - 1/4" DIA. STAINLESS STEEL BOLTS WITH LOCKING NUTS. TYP. EACH SIDE.

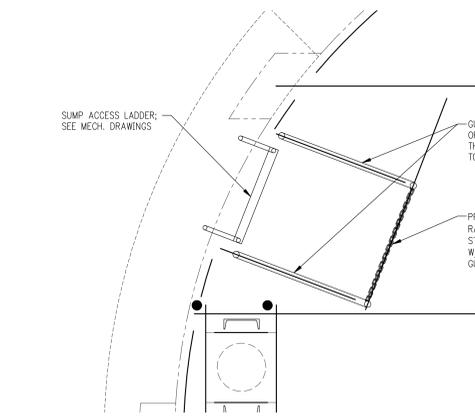


3 DETAIL: BEAM BEARING AT EL. 24'-0"
 SCALE: 3/8" = 1'-0"

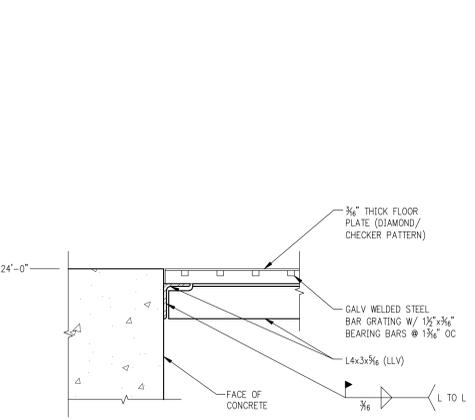


6 SECTION: ANGLE TO ANGLE CONNECTION
 SCALE: 1/2" = 1'-0"

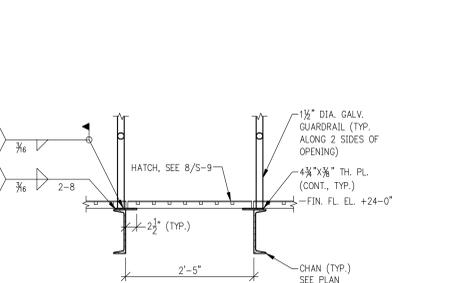

9 SECTION: GUARDRAIL/PLATE CONNECTION
 SCALE: 3/8" = 1'-0"
 NOTES:
 • PROVIDE OPENINGS IN ORTG AND PLATE AS REQ'D FOR INSTALLATION OF GUARDRAIL

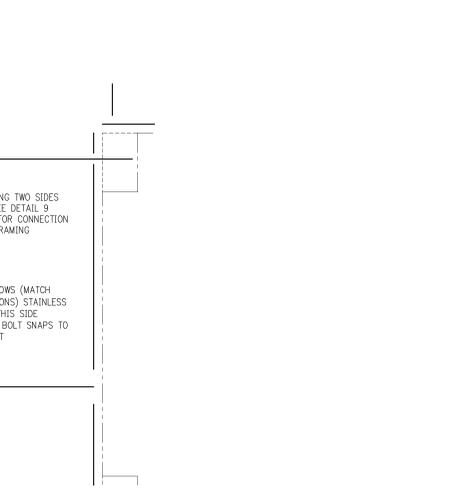

4 DETAIL: W14 CONN. AT ELEV. PIT WALL
 SCALE: 3/8" = 1'-0"
 NOTES:
 • CONNECTION OCCURS AT BOTH ENDS OF STEEL BEAM

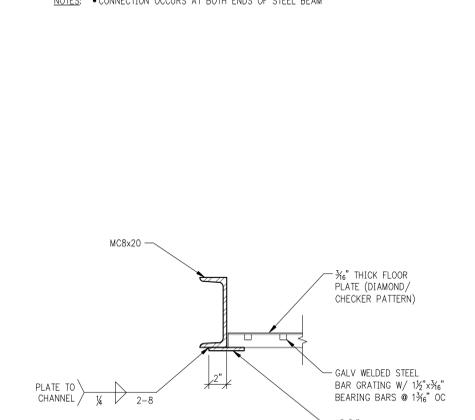

7 SECTION: CHANNEL/GRATING CONNECTION
 SCALE: 1/2" = 1'-0"



10 PLAN: PUMP FRAMING DIMENSIONS
 SCALE: 1/4" = 1'-0"
 NOTES:
 • DIMENSIONS TO PUMP SUPPORT STEEL ARE MEASURED TO BACK FACE OF MC SECTION



11 PLAN: SUMP ACCESS
 SCALE: 3/8" = 1'-0"



ISSUE DATES
ISSUED FOR CONSTRUCTION
PHASE TWO: PUMPS & TIE IN TO WWTP
 10 JULY 2009



TETRA TECH ENGINEERS, ARCHITECTS & LANDSCAPE ARCHITECTS, P.C.
 56 West Main Street
 Christina, Delaware 19702-1501
 ph. 302.735-7551
 fax 302.454-5980
 www.tetrotech-de.com


RN: 112IC02194
 DRAWN BY: ATC/SEH
 CHECKED BY: ATC
 SCALE: AS NOTED
 APPROVED BY: HKM
 DATE: 10 JULY 2009
 CAD FILE: 112IC02194\DWG\NEW\S-9

General Electric Company
 TUNNEL/RAIN
 COLLECTION SYSTEM
 Hudson Falls, New York

SUMP FRAMING PLAN
 AND DETAILS
 DRAWING TITLE:
 DRAWING NUMBER: S-9

WWTP PLC

WWTP PLC

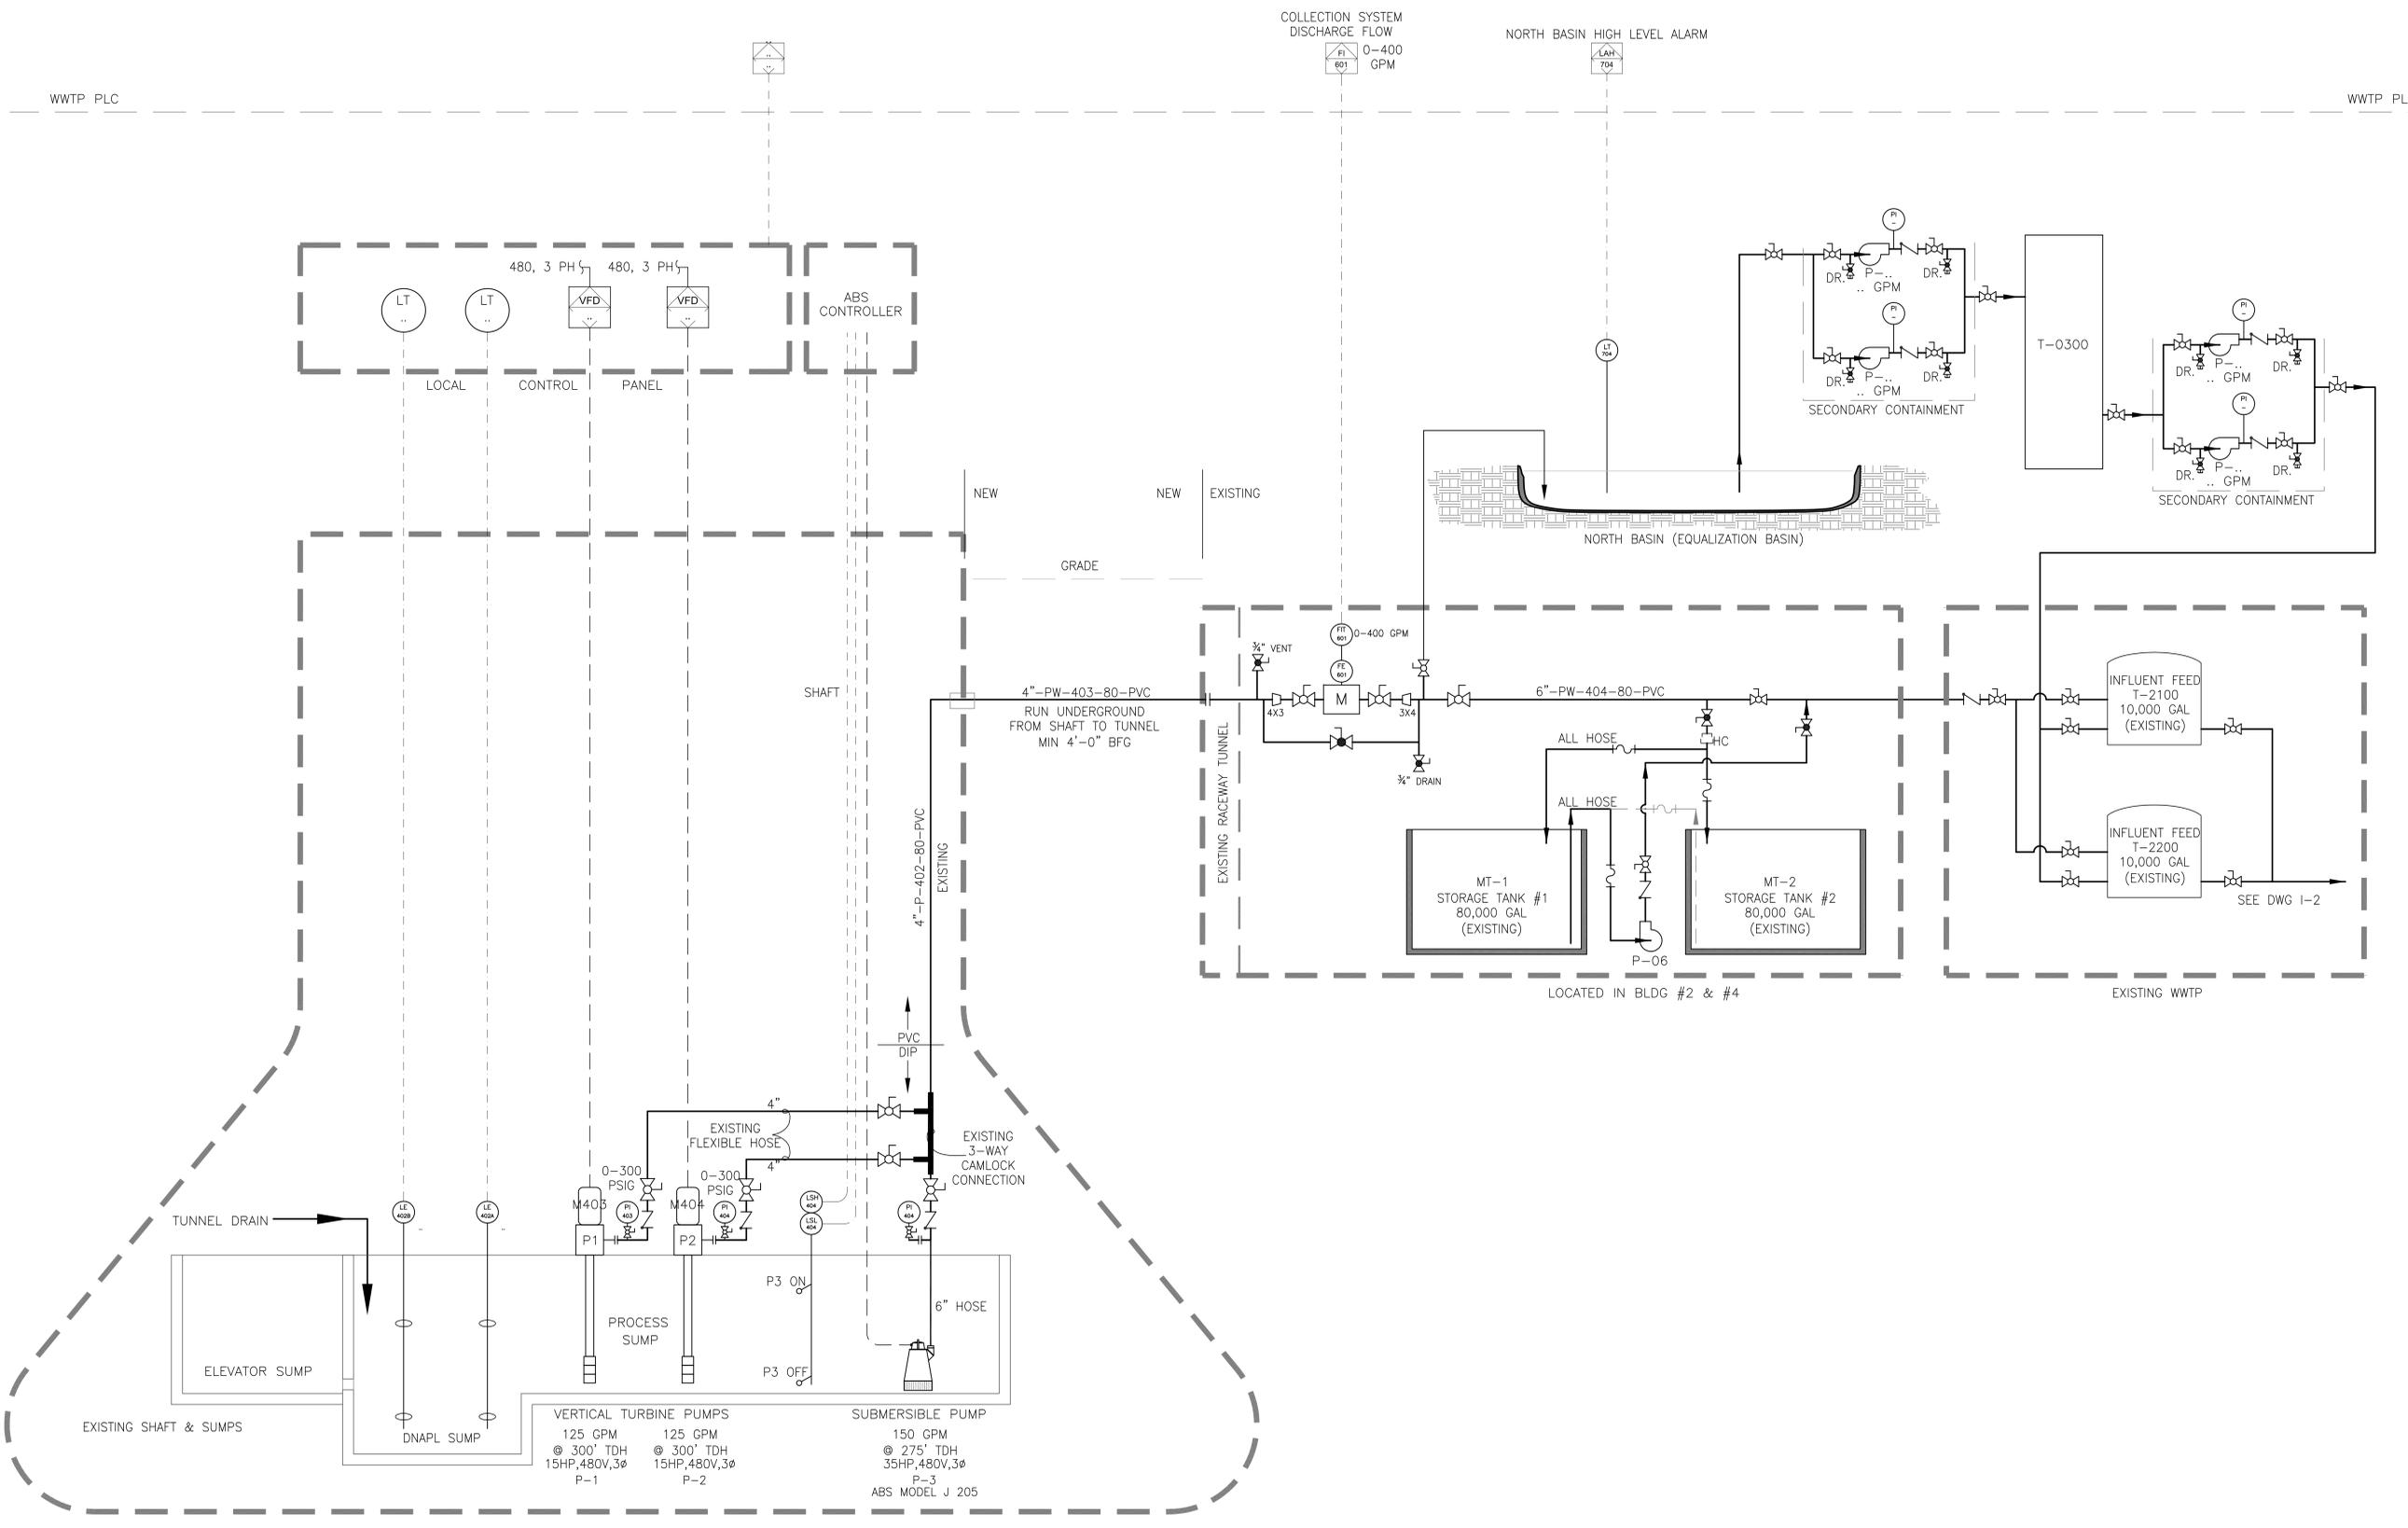

ISSUE DATES

ISSUED FOR CONSTRUCTION
 PHASE ONE: SHAFT AND TUNNEL
 25 JULY 2007
 ISSUED FOR REVIEW
 PHASE TWO: PUMP INSTALLATION
 20 AUGUST 2009

CONSULTANTS

TETRA TECH
 240 Continental Drive, Suite 200
 Newark, Delaware 19713
 ph. 302 738-7551
 fax 302 454-5988
 www.tetrattech-de.com

RCN: 112IC02194
 DRAWN BY: SNL
 CHECKED BY: HKM
 SCALE: NOT TO SCALE
 APPROVED BY: CKH
 DATE: 20 AUGUST 2009
 CAD FILE: SEE PLOT STAMP

General Electric Company

TUNNEL/ DRAIN
 COLLECTION SYSTEM


Hudson Falls, New York

PIPING AND INSTRUMENT DIAGRAM

DRAWING TITLE:

DRAWING NUMBER:

K:\112002194 - Hudson Falls\Drawings\Working Drawings\Mechanical\PLD_1.dwg 09/20/2009 13:30

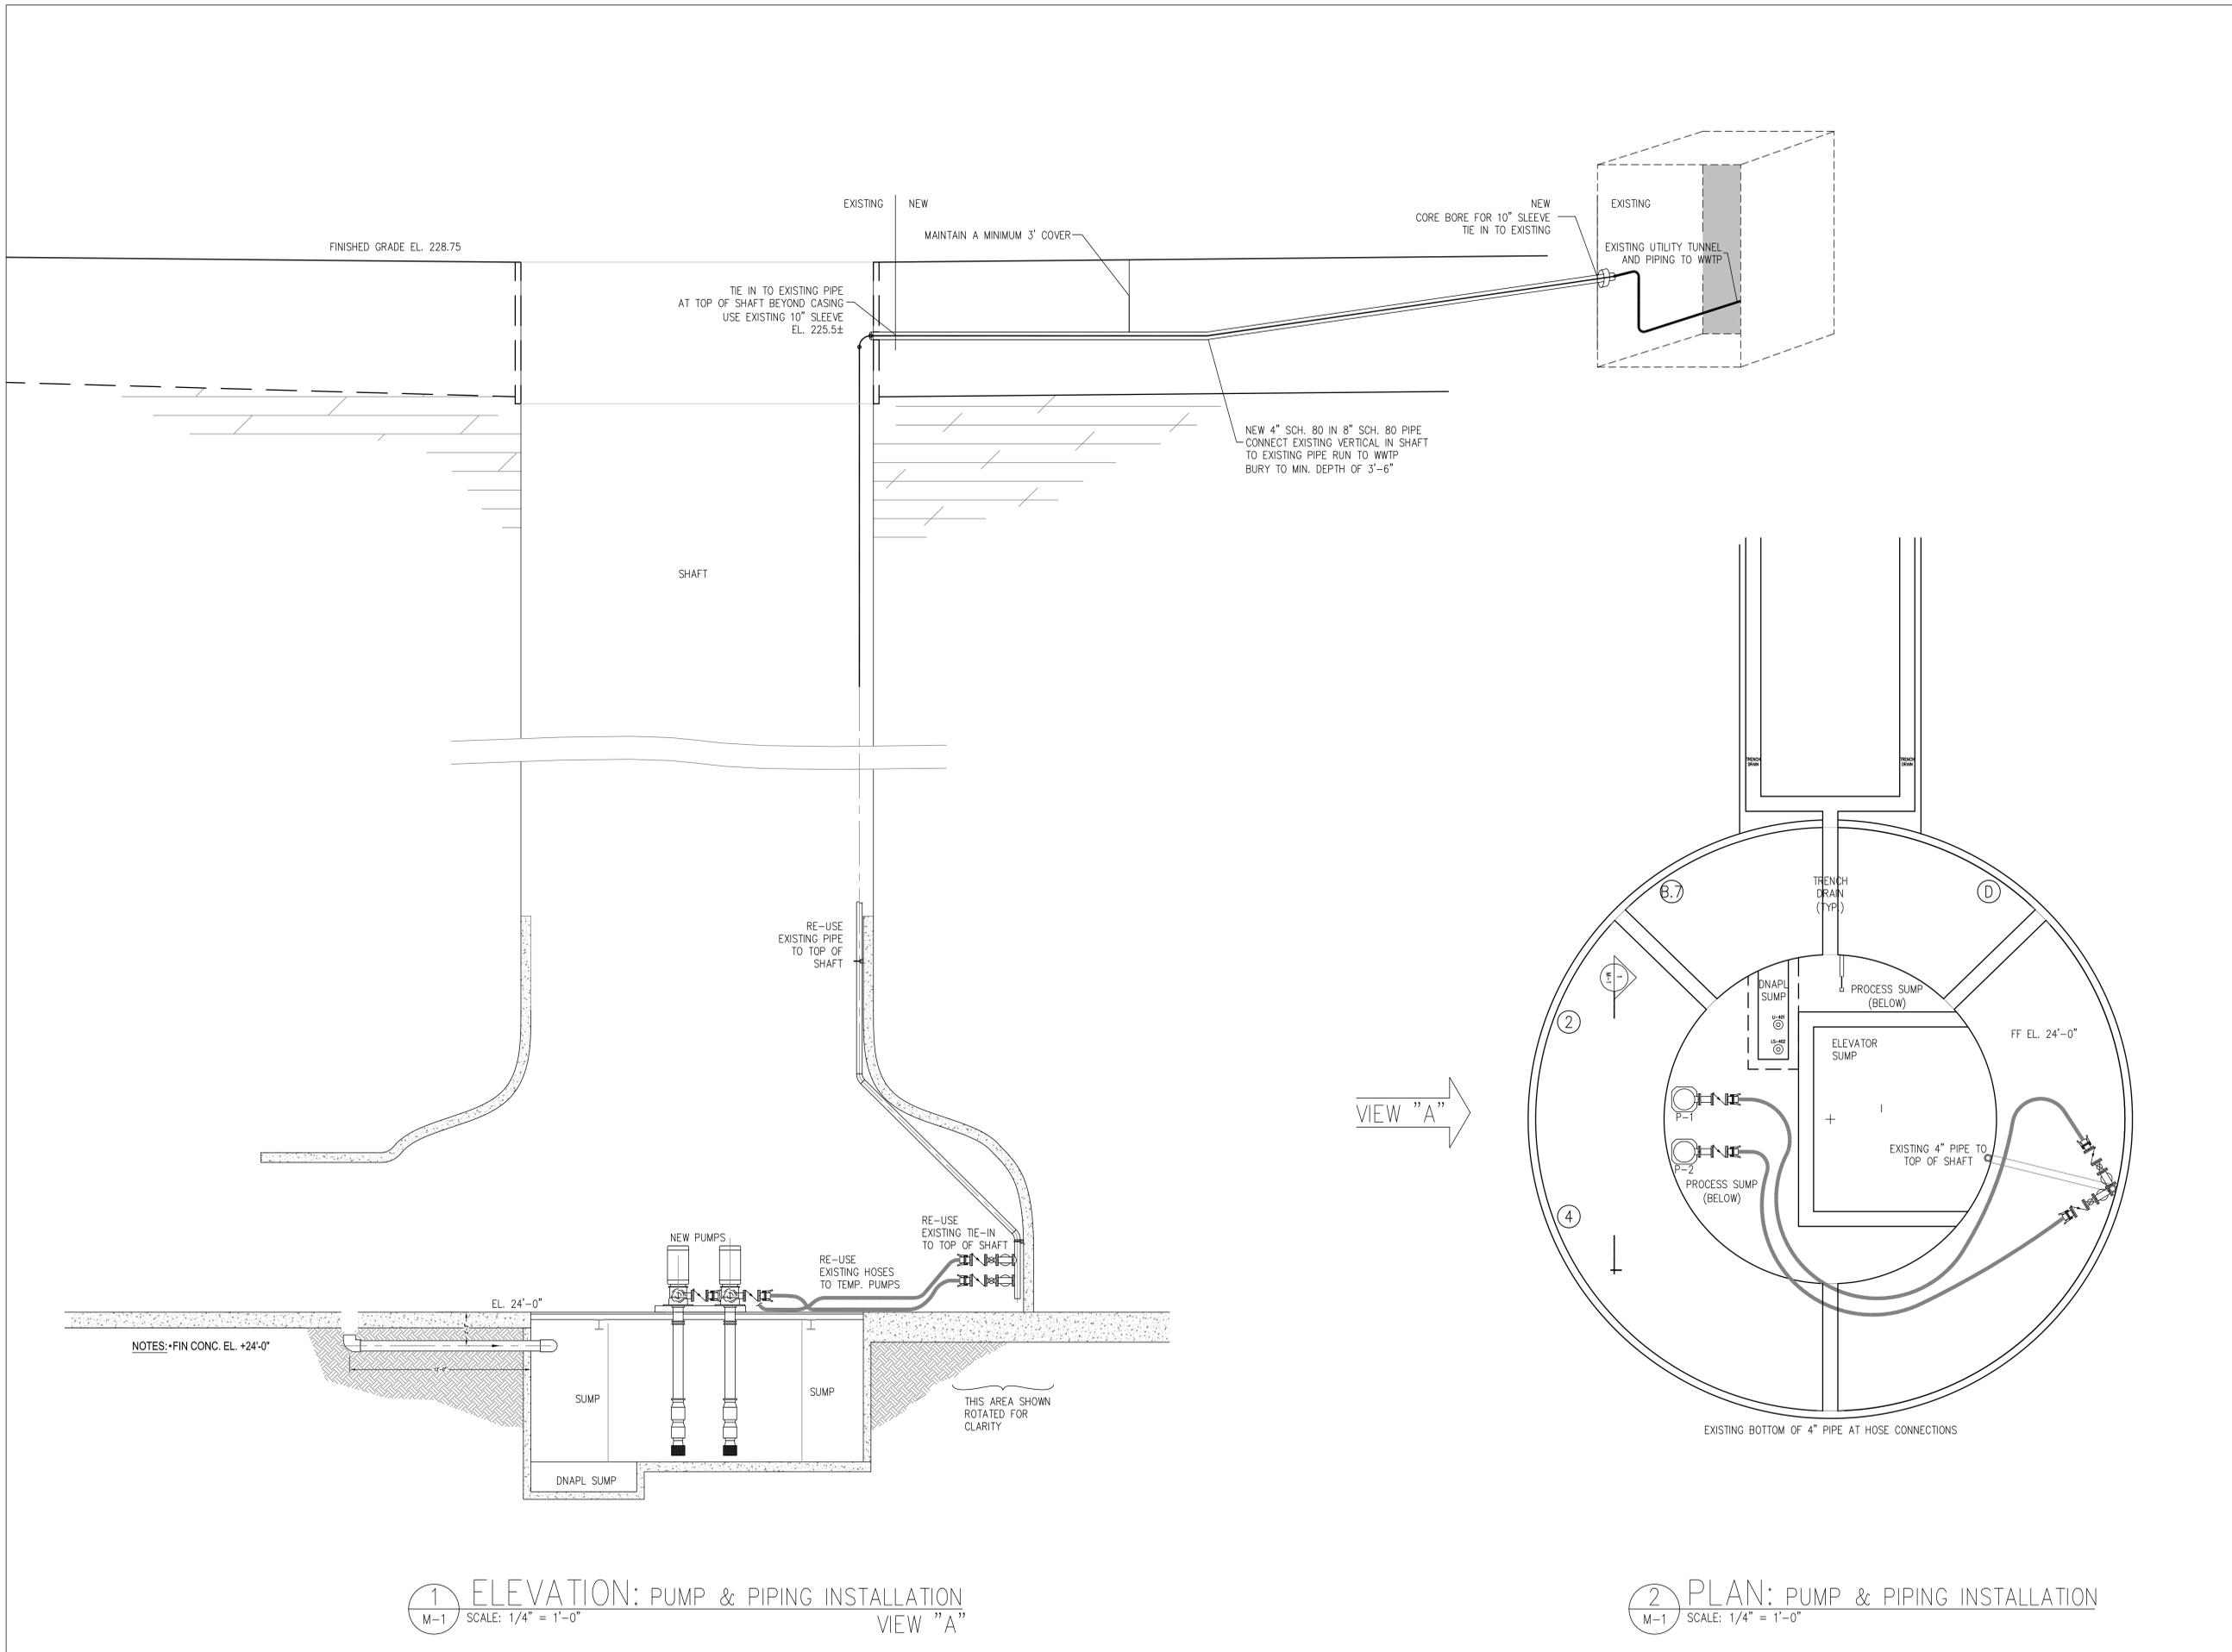

1 ELEVATION: PUMP & PIPING INSTALLATION
M-1 SCALE: 1/4" = 1'-0"
VIEW "A"

2 PLAN: PUMP & PIPING INSTALLATION
M-1 SCALE: 1/4" = 1'-0"

ISSUE DATES
ISSUED FOR CONSTRUCTION
PHASE TWO: PUMPS & TIE IN TO WWTP
10 JULY 2009

CONSULTANTS


TETRA TECH ENGINEERS, ARCHITECTS & LANDSCAPE ARCHITECTS, P.C.
56 West Main Street
Christiana, Delaware 19702-1501
ph. 302 738-7551
fax 302 454-5980
www.tetratech-de.com

RCN: 112IC02194
DRAWN BY: SNL
CHECKED BY: HKM
SCALE: AS NOTED
APPROVED BY:
DATE: 10 JULY 2009
CAD FILE: M-11


General Electric Company
TUNNEL/DRAIN
COLLECTION SYSTEM
Hudson Falls, New York

PIPING LAYOUT
PLAN AND ELEVATION
DRAWING TITLE:


DRAWING NUMBER: M-11
P&E

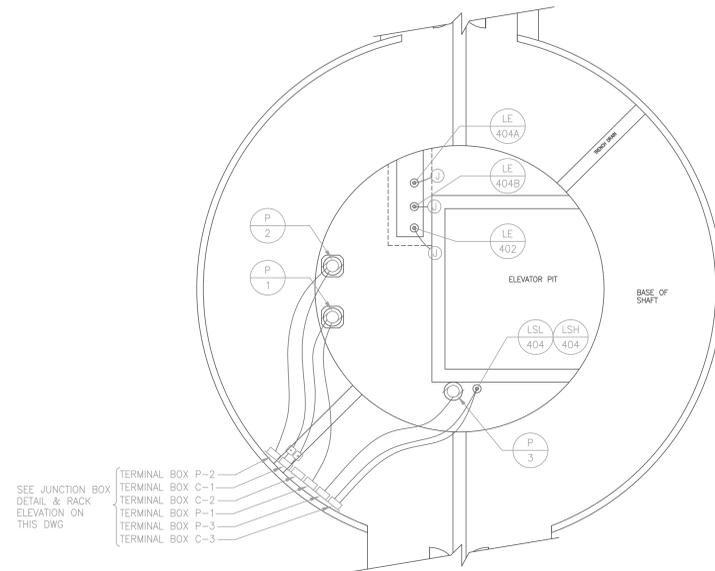


ELECTRICAL PLAN
SCALE: 3/16" = 1'-0"

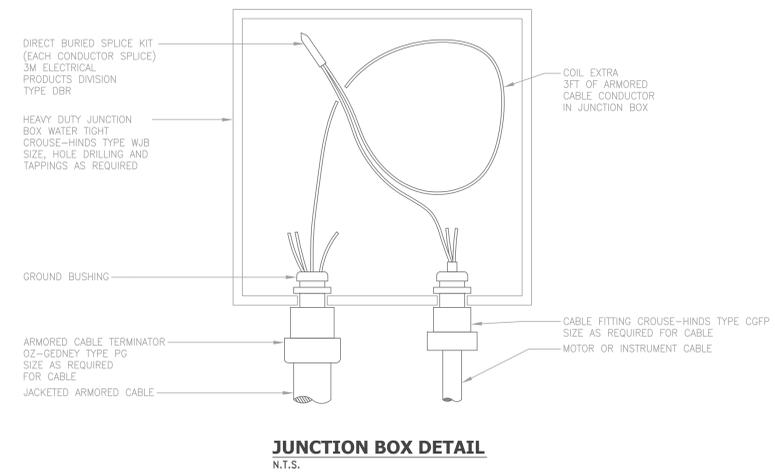

JUNCTION BOX DETAIL
N.T.S.

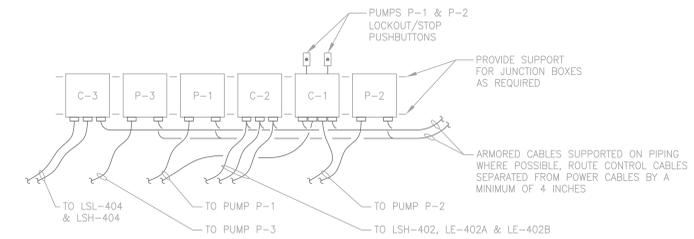

JUNCTION BOX RACK ELEVATION
N.T.S.

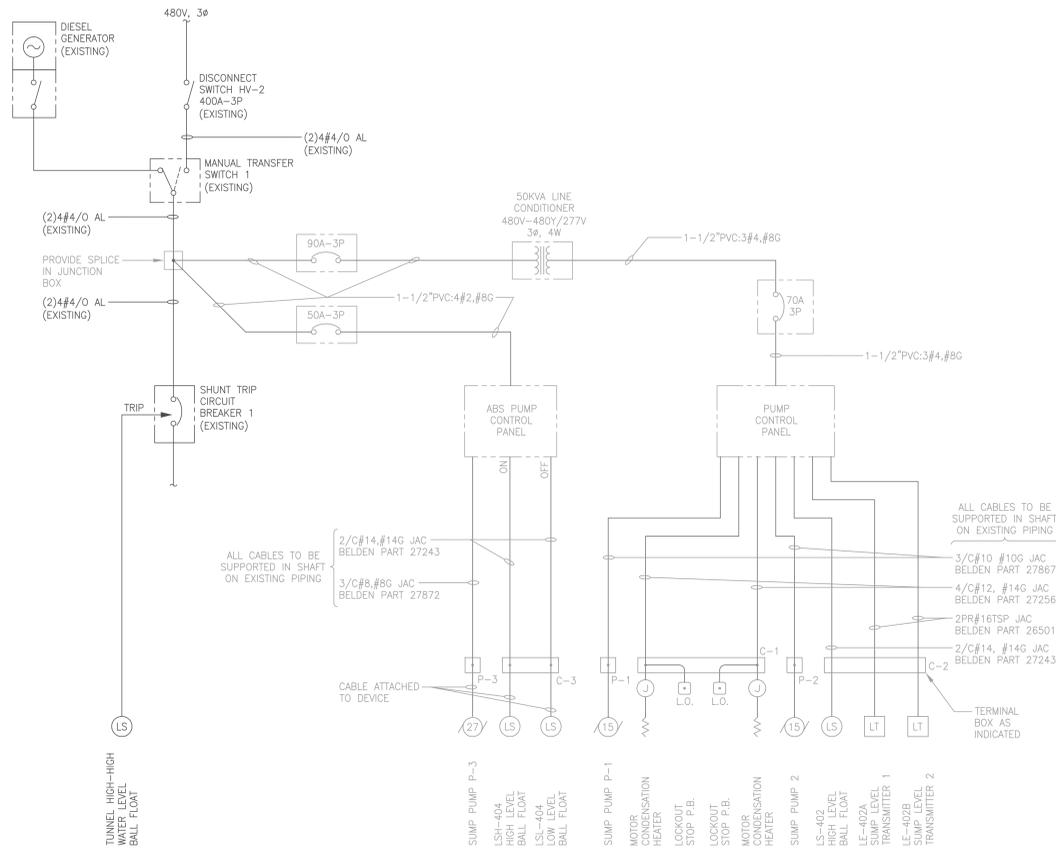

SINGLE LINE DIAGRAM
N.T.S.

SPECIFICATIONS:

- LINE CONDITIONER:
50kVA, 480V-480Y/277V, 3Ø, 4W
INPUT VOLTAGE RANGE: 480V, -25% TO +15%
OUTPUT VOLTAGE RANGE: 480Y/277V, +/-5%
RESPONSE TIME: <1.5 CYCLES
OPERATING FREQUENCY: 57-63 Hz
EFFICIENCY: 98%
WEIGHT: 950LBS
AUDIBLE NOISE LEVEL: <50dBA AT 3FT
AMBIENT TEMPERATURE: 0° TO 40°C
UL LISTED: UL1612 AND UL 1449-2
SOLA/HEVI-DUTY SOLATRON PLUS
THREE PHASE POWER CONDITIONER
CAT. NO. 63TCC350
- LEVEL TRANSDUCER:
SENSING RANGE: 0-15FT OF WATER
SUPPLY VOLTAGE: 9-30VDC (LOOP POWERED)
OUTPUT SIGNAL: 4-20mA DC
ACCURACY: +/-0.1% FULL SCALE
STABILITY: +/-0.1% PER YEAR
INTEGRAL SURGE ARRESTER (LEVEL 4)
FLUOROPOLYMER VENTED CABLE
ACCESSORY PACK TAS-A187
GE SENSING - DRUCK MODEL PTX1885
- BALL FLOAT LEVEL SWITCH:
CONTACT: SPDT
RATING: 4AMPS AT 120V
MATERIAL: POLYPROPYLENE
CABLE TYPE: ST00W

NOTES:

- JAC = JACKETED ARMORED CABLE
- TRANSFORMER, CIRCUIT BREAKER AND PUMP CONTROL PANEL TO BE LOCATED IN WEATHER SHELTER AT TOP OF SHAFT. MOUNTING AND SHELTER EXPANSION TO BE FILED AS REQUIRED.

ISSUE DATES

ISSUED FOR CONSTRUCTION
PHASE ONE: SHAFT AND TUNNEL
25 JULY 2007
ISSUED FOR REVIEW
PHASE TWO: PUMP INSTALLATION
20 AUGUST 2009

CONSULTANTS

CAREW ASSOCIATES, INC.
CONSULTING ENGINEERS
2 Paines Way, Suite 203
New Castle Corporate Commons
New Castle, DE 19720
p. 302.328.3600
f. 302.328.3601
e. design@carewassoc.com (302-328-3600)

TETRA TECH

240 Continental Drive, Suite 200
Newark, Delaware 19713
ph. 302.735.7551
fax. 302.454.5988
www.tetratech-de.com

RCN: 112/002194
DRAWN BY: DFD
CHECKED BY: RKR
SCALE: AS NOTED
APPROVED BY: RC
DATE: 20 AUGUST 2005
CAD FILE: E-9.DWG

General Electric Company

TUNNEL/DRAIN
COLLECTION SYSTEM

Hudson Falls, New York

ELECTRICAL PLANS
& DIAGRAMS

DRAWING TITLE:

DRAWING NUMBER:

E-9
PWS