

Meacham Lake

NORMAL WATER LEVEL 82.0

SITE GRADING PLAN


SCALE: 1" = 30'

NOTE: ANY BOULDERS OR LARGE STONES FOUND DURING THE CLEARING, GRUBBING AND EXCAVATION PROCESS SHALL BE USED ON SITE AS LANDSCAPE MATERIAL.

LAUNCH RAMP AREA GRADING PLAN

SCALE: 1" = 20'

**Department of
Environmental
Conservation**

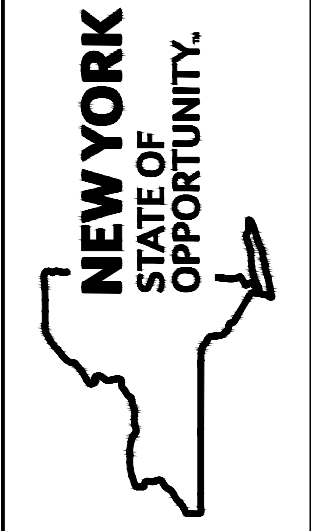

DIVISION OF OPERATIONS
BUREAU OF DESIGN AND CONSTRUCTION

DESIGNED BY	CHECKED BY	DRAWN BY
D.P.B.	K.W.L.	J.P.E.

NO.	DATE	DESCRIPTION

FACILITY NAME	MEACHAM LAKE CAMPGROUND
FACILITY NO.	0050
PROJECT NO.	68984
DATE	APRIL, 2015
SCALE	AS NOTED
DRAWING NO.	4

PROJECT DESCRIPTION
MEACHAM LAKE CAMPGROUND
BOAT LAUNCH SITE

SITE GRADING PLAN

AS BUILT

